

**SURVEY & REMONUMENTATION**

STATE OF MICHIGAN  
COUNTY OF KALAMAZOO  
RECEIVED FOR RECORD

1  
2  
APR 27 1995

'95 JAN 17 PM 12 39

**COMMISSION**

**LAND CORNER RECORDATION CERTIFICATE**  
Filing Requirement of Act 74, Mich. P.A. 1970

*James J. Jones*  
CLERK-REGISTER

For corners in


<u>Kalamazoo</u> (County)	Located In:	Corner Code #
Ross Township	T <u>1</u> S R <u>9</u> W	<u>K-6</u>
1. Public Land Survey	T _____ R _____	_____
	T _____ R _____	_____
	T _____ R _____	_____
2. Property Controlling in Section	S _____ T _____ R _____	_____
	S _____ T _____ R _____	_____
3. Miscellaneous Property in Sec.	S _____ T _____ R _____	_____
	S _____ T _____ R _____	_____

LIBER **1** PG **1265**

Register of Deeds Stamp & File Number

4. Lot No. \_\_\_\_\_, Recorded Plat \_\_\_\_\_  
5. Private Claims \_\_\_\_\_

I, Robert E. Snell, in a field survey on July 15, 19 94, do hereby certify that under requirements of P.A. 74, Michigan P.A. of 1970, the corner points mentioned in lines 1 and 2 above were in conformance with regulations and rules therefore as required in the current manual of survey instructions of the United States Department of the Interior, Bureau of Land Management or by a decree of a Court of Law and/or that the corner points mentioned in lines 3, 4 and 5 above were in conformance with the rules of the Michigan Board of Land Surveyors or by a Decree of a Court of Law; established, re-established, monumented, re-monumented, recovered, found as expressed below:

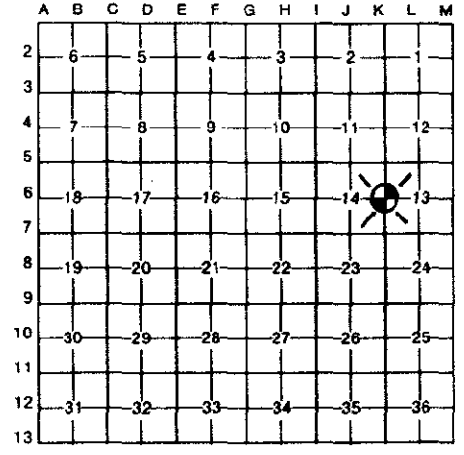

**NOTE: Not more than 4 corners, all in the same town and range, may be recorded on this certificate.**

A. Description of original monument and accessories and/or subsequent restoration:

1825: U.S. Government Survey; Set 1/4 Section Post.  
Wh. Oak 15" South 04° East 33 Lks  
Wh. Oak 8" North 27° West 6 Lks

1883: F.Hodgman, County Surveyor; Found stone with stake under in center of Road and (in) line with fence (to) West. No trace of bearing trees. Bored 3', put coal in bottom and 2' earthen post over and marked;  
Hickory 6" South 26° West 95½ Lks  
Maple 3" North 69½° West 41 Lks (not marked)

B. Description of corner evidence found and/or method applied in restoring or reestablishing corner:

1994: Found 3" round tile in monument box. A 1/2" x 12" long iron pipe was over tile, 0.04' East and 0.04' North of Centerline of tile.

**RATIFIED**  
**BY KALAMAZOO COUNTY**  
**REMONUMENTATION**  
**PEER GROUP**  
9/15/94  
*R.E.S.*

C. Description of monument for corner and accessories established to perpetuate locating the position of the corner:

K-6 East 1/4 Post Section 14, T. 1 S., R. 9 W., Ratified by the Kalamazoo County Remonumentation Program Peer Group on September 15, 1994. Found 3" round tile as called for in 1883 remonumentation survey by F.Hodgman and is accepted as a careful and faithful perpetuation of the position of the original corner. Placed a remonumentation sleeve over tile with old monument box over sleeve.

In Centerline of 46" Street at "C-D" Avenue  
Exist. 60d Spike in West Side of 35" Maple South 38° East 39.00'  
Exist. 60d Spike in East Side of 36" Maple North 20° West 55.90'  
Exist. 60d Spike in North Side of 36" Maple North 70° West 26.93'  
Exist. 60d Spike in Southeast Side of 32" Oak South 44° West 39.06'

Signed by *Robert E. Snell* Date 1-17-95  
Surveyor's Michigan License No. 9734