1
2

LAND CORNER RECORDATION CERTIFICATE

Filing Requirement of Act 74, Mich. P.A. 1970

LIBER 2 PAGE 329

STATE OF MICHIGAN
COUNTY OF KALAMAZOO
RECEIVED FOR RECORD
'98 OCT 12 PM 1 29
CLERK - REGISTER

Register of Deeds Stamp & File Number

For corners in Richland Twp.
Kalamazoo
(County)

	Located In:	Corner Code #
1. Public Land Survey	T 1S. R 10W.	A-12
	T ___ R ___	
	T ___ R ___	
	T ___ R ___	
2. Property Controlling	S ___ T ___ R ___	
in Section	S ___ T ___ R ___	
3. Miscellaneous	S ___ T ___ R ___	
Property in Section	S ___ T ___ R ___	

4. Lot No. _____, Recorded Plat _____
5. Private Claims _____

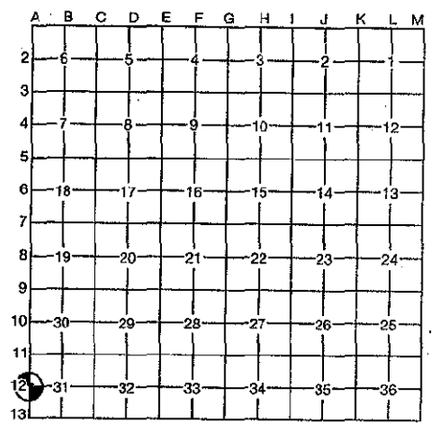

I, Allen H. McMachen, in a field survey on March 13, 19 98 do hereby certify that under requirements of P.A. 74, Michigan P.A. of 1970, the corner points mentioned in lines 1 and 2 above were in conformance with regulations and rules therefore as required in the current manual of survey instructions of the United States Department of the Interior, Bureau of Land Management or by a decree of a Court of Law and/or that the corner points mentioned in lines 3, 4 and 5 above were in conformance with the rules of the Michigan Board of Professional Surveyors or by a Decree of a Court of Law; established, re-established, monumented, re-monumented, recovered, found as expressed below:

NOTE: Not more than 4 corners, all in the same town and range, may be recorded on this certificate.

A. Description of original monument and accessories and/or subsequent restoration:

Corner not placed by original government surveyors.
1950's - Replaced Section corner per K. Wilkins witnesses from 1944-(Job No. 8860), N. & S. fence West 29', Fence to West is South 8', Measured North 2657.7' to N.W. corner (tile), Measured South 2660.85' to S.W. cor. (tile), Measured East 2259.8' to C. ¼ cor. (stone).

B. Description of corner evidence found and/or method applied in restoring or reestablishing corner:

Found ¾" iron rod 8' North of fence to West. Measured North 2656.43' to N.W. cor. (Std. marker over stone), Measured South 2660.03' to S.W. cor. (Std. marker over tile), Measured East 2258.99' to C. ¼ cor. (Std. marker over stone).

SURVEY &
REMONUMENTATION
NOV 25 1998
SECTION

RATIFIED
BY KALAMAZOO COUNTY
REMONUMENTATION
PEER GROUP
4/16/98 R.E.S.

C. Description of monument for corner and accessories established to perpetuate locating the position of the corner:

Found iron is accepted as a careful and faithful perpetuation of the position of the original corner, replaced found iron with a 30" Harrison Monument with mon. box over, Accessories:

60d Nail & Tab in NE side 14" Triple Maple N. 60° W. 59.55'
60d Nail & Tab in North side 32" Maple N. 75° E. 69.62'
60d Nail & Tab in NW side 16" Maple S. 60° E. 84.70'
60d Nail & Tab in SE side 34" Oak S. 35° W. 80.32'

STATE OF MICHIGAN
ALLEN H.
McMACHEN
PROFESSIONAL
SURVEYOR
No.
16935
LICENSED PROFESSIONAL SURVEYOR

Signed by Allen H McMachen Date 10/9/98
Surveyor's Michigan License No. 16935

FORM APPROVED BY MICHIGAN STATE BOARD OF PROFESSIONAL SURVEYORS, JAN. 28, 1971
REVISED MAY 14, 1975
REVISED JAN., 1983