

**SURVEY & REMONUMENTATION**

MAY 28 1957

COMMISSION

**LAND CORNER RECORDATION CERTIFICATE**  
Filing Requirement of Act 74, Mich. P.A. 1970

For corners in


Kalamazoo (County)	Located in:	Corner Code #
Richland	T1S R10W	B-04
1. Public Land Survey	T___ R___	_____
	T___ R___	_____
	T___ R___	_____
2. Property Controlling in Section	S___ T___ R___	_____
	S___ T___ R___	_____
3. Miscellaneous Property in Sec.	S___ T___ R___	_____
	S___ T___ R___	_____

STATE OF MICHIGAN  
COUNTY OF KALAMAZOO  
RECEIVED FOR RECORD  
96 AUG 26 PM 4 00  
2 PAGE  
049  
LIBER  
Register of Deeds Stamp & File Number

4. Lot No. \_\_\_\_\_, Recorded Plat \_\_\_\_\_  
5. Private Claims \_\_\_\_\_

I, Robert E. Snell, in a field survey on March 5, 1996 do hereby state that under requirements of P.A. 74, Michigan P.A. of 1970, the corner points mentioned in lines 1 and 2 above were in conformance with regulations and rules therefore as required in the current manual of survey instructions of the United States Department of the Interior, Bureau of Land Management or by a decree of a Court of Law and for that the corner points mentioned in lines 3, 4 and 5 above were in conformance with the rules of the Michigan Board of Land Surveyors or by a Decree of a Court of Law, established, re-established, monumented, recovered, found as expressed below:

NOTE: Not more than 2 corners, all in the same town and range, may be recorded on this certificate.

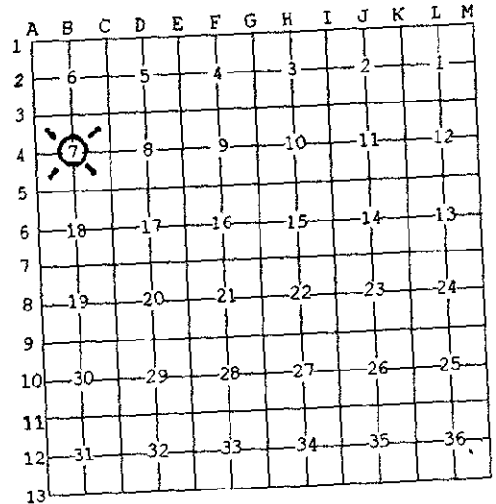

A. Description of original monument and accessories and/or subsequent restoration:  
1826: United States Government surveyors did not set this center section post.

1869: F. Hodgman, County Surveyor; set stake with brick and stone around.  
Hickory 10" N 29½° E 18 lks.  
Wh. Oak 10" N 73° E 77 lks.

B. Description of corner evidence found and/or method applied in restoring or reestablishing corner:

1992: Thomas W. Chettleburgh, RLS #16036; LCRC L-1, P-963. Found iron with bricks and stones per Kalamazoo County Surveyors records.  
Nail/tag South side 15" Oak N 75° W 18.68'  
Nail/tag Southwest side 15" Oak N 28° W 20.33'  
Nail/tag South side 16" Oak N 63° E 22.70'  
Nail/tag West side 32" Oak S 11° E 25.26'  
1" Iron Pipe N 28° W 1.41'

**RATIFIED**  
**BY KALAMAZOO COUNTY**  
**REMONUMENTATION**  
**PEER GROUP**  
7-18-1996

1996: Found iron with brick and stones using above witnesses.

C. Description of monument for corner and accessories established to perpetuate locating the position of the corner:

B-04: Center ¼ post Section 7, T 1 S, R 10 W; ratified by the Kalamazoo County Remonumentation Program Peer Group on July 18, 1996 and is accepted as a careful and faithful perpetuation for the position of the original corner. Found iron with brick and stone as set by F. Hodgman, County Surveyor in a 1869 survey. Placed 30" Harrison monument in place of the iron.  
(used same witnesses as listed in "B" above)

Signed by Robert E. Snell  
Surveyor's Michigan License No. 9734

Date 8-22-96