SURVEY & REMONUMENTATION

OCT 0 6 1997

COMMISSION

LIBER 2 PAGE 214

LAND CORNER RECORDATION CERTIFICATE

Filing Requirement of Act 74, Mich. P.A. 1970

For corners in Richland Twp. Kalamazoo (County)

	Located In:	Corner Code #
1. Public Land Survey	T 1S. R 10W.	B-11
	T ___ R ___	
	T ___ R ___	
	T ___ R ___	
2. Property Controlling	S ___ T ___ R ___	
in Section	S ___ T ___ R ___	
3. Miscellaneous	S ___ T ___ R ___	
Property in Section	S ___ T ___ R ___	

STATE OF MICHIGAN
COUNTY OF KALAMAZOO
RECEIVED FOR RECORD
'97 SEP 26 AM 11 10
CLERK - REGISTER

Register of Deeds Stamp & File Number

4. Lot No. _____, Recorded Plat _____
5. Private Claims _____

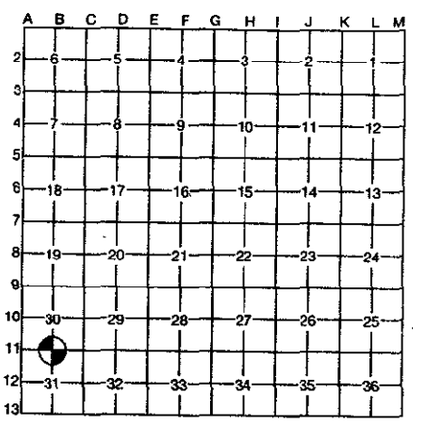

I, Allen H. McMachen, in a field survey on June 17, 19 96, do hereby certify that under requirements of P.A. 74, Michigan P.A. of 1970, the corner points mentioned in lines 1 and 2 above were in conformance with regulations and rules therefore as required in the current manual of survey instructions of the United States Department of the Interior, Bureau of Land Management or by a decree of a Court of Law and/or that the corner points mentioned in lines 3, 4 and 5 above were in conformance with the rules of the Michigan Board of Professional Surveyors or by a Decree of a Court of Law; established, re-established, monumented, re-monumented, recovered, found as expressed below:

NOTE: Not more than 4 corners, all in the same town and range, may be recorded on this certificate.

A. Description of original monument and accessories and/or subsequent restoration:

1827 - John Mullett, D.S., Set ¼ Sec. post, Wh. Oak 6" S. 74° W. 11 lks., Wh. Oak 10" N. 66° E. 27 lks.
1887 - F. Hodgman, C.S., "Found large stone set at intersection of roads. Set post, Hickory 12" N. 46° W. 55 lks., Hickory 14" S. 88½° W. 86 lks..
1905 - Ed Strong, C.S., "Tile is 1.8" below".

B. Description of corner evidence found and/or method applied in restoring or reestablishing corner:

Found ½" iron in Monument Box. Removed iron and box and found second iron directly under first iron. Removed 2nd iron and found clay tile at bottom of 2nd iron.

RATIFIED BY KALAMAZOO COUNTY REMONUMENTATION PEER GROUP
9-18-1997

C. Description of monument for corner and accessories established to perpetuate locating the position of the corner:

Position of found clay tile is accepted as a careful and faithful perpetuation of the position of the original corner. Placed standard Harrison Monument over tile and monument box, Accessories:

Nail & Tab in NW side of 10" Elm N. 37° W. 66.02'
Nail & Tab in West side Twin 10" Maple S. 31° E. 83.75'
Nail & Tab in East side Triple 10" Elm S. 30° W. 69.18'
"PK" Nail & Tab in NW side U. Pole N. 50° E. 55.20'

STATE OF MICHIGAN
ALLEN H. McMACHEN
PROFESSIONAL SURVEYOR
No. 16935
LICENSED PROFESSIONAL SURVEYOR

Signed by Allen H McMachen Date 9/26/97

Surveyor's Michigan License No. 16935

FORM APPROVED BY MICHIGAN STATE BOARD OF PROFESSIONAL SURVEYORS, JAN. 28, 1971
REVISED MAY 14, 1975
REVISED JAN., 1983