

SURVEY & REMONUMENTATION

MAY 16 1996

COMMISSION

STATE OF MICHIGAN
 COUNTY OF KALAMAZOO
 RECEIVED FOR RECORD
 '96 APR 22 PM 4 23

LAND CORNER RECORDATION CERTIFICATE
 Filing Requirement of Act 74, Mich. P.A. 1970

For corners in Kalamazoo Located In: _____ Corner Code # _____
 (County)
Richland Twp.


1. Public Land Survey	T 1 S.	R 10 W.	C-04
	T _____	R _____	_____
	T _____	R _____	_____
	T _____	R _____	_____
2. Property Controlling in Section	S _____	T _____	R _____
	S _____	T _____	R _____
3. Miscellaneous Property in Section	S _____	T _____	R _____
	S _____	T _____	R _____

James Young
 CLERK-REGISTER

LIBER 1 PAGE 1479

Register of Deeds Stamp & File Number

4. Lot No. _____, Recorded Plat _____
 5. Private Claims _____

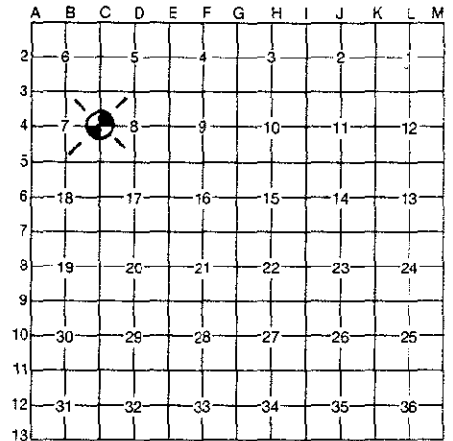

I, Robert E. Snell, in a field survey on February 13, 19 96, do hereby certify that under requirements of P.A. 74, Michigan P.A. of 1970, the corner points mentioned in lines 1 and 2 above were in conformance with regulations and rules therefore as required in the current manual of survey instructions of the United States Department of the Interior, Bureau of Land Management or by a decree of a Court of Law and/or that the corner points mentioned in lines 3, 4 and 5 above were in conformance with the rules of the Michigan Board of Professional Surveyors or by a Decree of a Court of Law; established, re-established, monumented, re-monumented, recovered, found as expressed below:

NOTE: Not more than 4 corners, all in the same town and range, may be recorded on this certificate.

A. Description of original monument and accessories and/or subsequent restoration:

1827: United States Government Surveyors; set 1/4 Section post.

Wh. Oak 30" S. 66° W. 38 lks.
 Wh. Oak 10" S. 81° E. 49 lks.

1857: F. Hodgman, County Surveyor; found brick and earthen corner of re-survey, set post.

Y. Oak 8" S. 70° W. 5 lks.
 Hickory 10" S. 0½° W. 39½ lks.

B. Description of corner evidence found and/or method applied in restoring or reestablishing corner:

1973: Al McMachen, R.L.S. #16935; L.C.R.C. L-1, P-744, found tile - no new accessories.

1996: Found 3" round tile with "x" on top at surface in East and West tree row with a well point on West side of tile.

RATIFIED
BY KALAMAZOO COUNTY
REMONUMENTATION
PEER GROUP
 3/21/96 *R. E. Snell*

C. Description of monument for corner and accessories established to perpetuate locating the position of the corner:

C-04: West 1/4 post, Section 7, T. 1 S., R. 10 W., Ratified by the Kalamazoo County Remonumentation Program Peer Group on March 21, 1996 and is accepted as a careful and faithful perpetuation of the position of the original corner. Found 3" round tile with "x" on top as set by F. Hodgman in a Remonumentation survey in 1887. Placed remonumentation sleeve over tile.

PK Nail in South Side	24" W. Cherry	S. 74° E.	22.68'
PK Nail in East Side	7" W. Cherry	S. 40° W.	5.01'
PK Nail in South Side	8" Hickory	N. 64° W.	18.20'
PK Nail in West Side	18" W. Cherry	N. 20° W.	8.56'

Signed by *Robert E. Snell*
 Surveyor's Michigan License No. 9734

Date 4-19-96