

**SURVEY & REMONUMENTATION**

AUG 06 1996

COMMISSION

**LAND CORNER RECORDATION CERTIFICATE**  
**Filing Requirement of Act 74, Mich. P.A. 1970**

For corners in  
Kalamazoo  
(County)  
Richland Twp.

Located In:

Corner Code #

1. Public Land Survey	T <u>1</u> S. R <u>10</u> W.	<u>C-05</u>
	T _____ R _____	_____
	T _____ R _____	_____
	T _____ R _____	_____
2. Property Controlling in Section	S _____ T _____ R _____	_____
	S _____ T _____ R _____	_____
3. Miscellaneous Property in Section	S _____ T _____ R _____	_____
	S _____ T _____ R _____	_____


STATE OF MICHIGAN  
 COUNTY OF KALAMAZOO  
 RECEIVED FOR RECORD  
 96 JUN 7 PM 2 27  
*James M. [Signature]*  
 CLERK - REGISTER

LIBER 2PAGE 031

Register of Deeds Stamp & File Number

4. Lot No. \_\_\_\_\_, Recorded Plat \_\_\_\_\_  
 5. Private Claims \_\_\_\_\_

I, Robert E. Snell, in a field survey on March 4, 1996, do hereby certify that under requirements of P.A. 74, Michigan P.A. of 1970, the corner points mentioned in lines 1 and 2 above were in conformance with regulations and rules therefore as required in the current manual of survey instructions of the United States Department of the Interior, Bureau of Land Management or by a decree of a Court of Law and/or that the corner points mentioned in lines 3, 4 and 5 above were in conformance with the rules of the Michigan Board of Professional Surveyors or by a Decree of a Court of Law; established, re-established, monumented, re-monumented, recovered, found as expressed below:

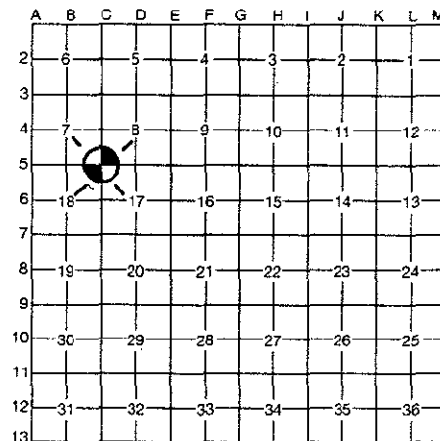

**NOTE: Not more than 4 corners, all in the same town and range, may be recorded on this certificate.**

**A. Description of original monument and accessories and/or subsequent restoration:**

1826: United States Government Surveyors; set post common to Sections 7, 8, 17 and 18.

Wh. Oak 8" S. 28° W. 40 lks.  
 Wh. Oak 8" N. 34° W. 38 lks.

1887: F. Hodgman, County Surveyor; found stone and crockery of resurvey. Set post with crockery under.

Y. Oak 8" S. 74° E. 80½ lks.  
 Y. Oak 4" N. 24° E. 50 lks.

**B. Description of corner evidence found and/or method applied in restoring or reestablishing corner:**

1958: Wilkins & Wheaton Engineering Co.; found tile.

30" Oak Northeast 55'  
 12" Oak North 36.85'  
 NW corner Tower 60.7'  
 24" Oak N. 20° E. 31.7'

1996: Found tile in monument box.

*R.E.S.*  
**RATIFIED**  
**BY KALAMAZOO COUNTY**  
**REMONUMENTATION**  
**PEER GROUP**  
 3-21-1996

**C. Description of monument for corner and accessories established to perpetuate locating the position of the corner:**

C-05: Southeast corner Section 7, T. 1 S., R. 10 W., ratified by the Kalamazoo County Remonumentation Program Peer Group on March 21, 1996, and is accepted as a careful and faithful perpetuation of the position of the original corner. Found 3" round tile as set by F. Hodgman, County Surveyor in 1887 remonumentation survey. Placed remonumentation sleeve over tile in monument box.

Nail and Tab on East Side of 6" Juniper S. 02° E. 57.15'  
 Northwest corner of Transformer Tower Leg S. 50° E. 60.55'  
 PK Nail on West Side of 8" Juniper S. 30° W. 33.75'  
 PK Nail on East Side of 24" Oak N. 40° W. 73.94'

Signed by Robert E. Snell  
 Surveyor's Michigan License No. 9734

Date 6-6-96