

**SURVEY & REMONUMENTATION**

JUL 28 1997

COMMISSION

**LAND CORNER RECORDATION CERTIFICATE**  
**Filing Requirement of Act 74, Mich. P.A. 1970**

LIBER 2 PAGE 132

For corners in Richland Twp.  
Kalamazoo  
 (County)

Located In: \_\_\_\_\_ Corner Code # \_\_\_\_\_

1. Public Land Survey	T	<u>1S.</u>	R	<u>10W.</u>	<u>C-7</u>
	T	_____	R	_____	_____
	T	_____	R	_____	_____
	T	_____	R	_____	_____
2. Property Controlling in Section	S	_____	T	_____	_____
	S	_____	T	_____	_____
3. Miscellaneous Property in Section	S	_____	T	_____	_____
	S	_____	T	_____	_____

STATE OF MICHIGAN  
 COUNTY OF KALAMAZOO  
 RECEIVED FOR RECORD


97 MAY 16 PM 3 49

CLERK - REGISTER

Register of Deeds Stamp & File Number

4. Lot No. \_\_\_\_\_, Recorded Plat \_\_\_\_\_
5. Private Claims \_\_\_\_\_
6. IWM Job No. 26689

I, Allen H. McMachen, in a field survey on March 31, 19 97, do hereby certify that under requirements of P.A. 74, Michigan P.A. of 1970, the corner points mentioned in lines 1 and 2 above were in conformance with regulations and rules therefore as required in the current manual of survey instructions of the United States Department of the Interior, Bureau of Land Management or by a decree of a Court of Law and/or that the corner points mentioned in lines 3, 4 and 5 above were in conformance with the rules of the Michigan Board of Professional Surveyors or by a Decree of a Court of Law; established, re-established, monumented, re-monumented, recovered, found as expressed below:

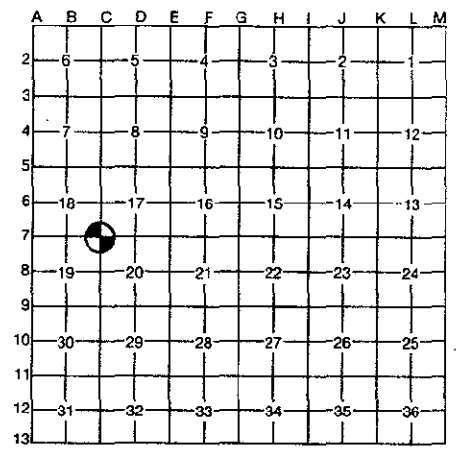

**NOTE: Not more than 4 corners, all in the same town and range, may be recorded on this certificate.**

**A. Description of original monument and accessories and/or subsequent restoration:**

1827 - John Mullett, D.S., corner to Sec. 17, 18, 19 & 20 on a Wh. Oak 14".  
1887 - F. Hodgman, C.S., "Corner tree removed, set post in the hole where stump came out in line with fence East and West Y. Oak 10" S. 23° E. 47 lks., Hickory 8" S. 36° W. 53 lks.

1973 - Ingersoll, Watson & McMachen, Inc., "Found iron pipe, nothing under, set box in West edge of pavement, Tw. 8" Cherry N. 45° E., 20" Oak East 32.00', Hickory Stump S. 45° E. 63'.

**B. Description of corner evidence found and/or method applied in restoring or reestablishing corner:**

Found iron pipe in monument box per 1973 witnesses. Removed pipe and found a second pipe directly under first pipe. Removed second pipe and excavated 4' below grade and probed 2' further and found no further evidence. Area appears to have been cut ±15' for roadway. Measured East 2612.39' to North quarter corner and measured South 2642.96' to West quarter corner.

**RATIFIED BY KALAMAZOO COUNTY REMONUMENTATION PEER GROUP**  
 4-16-1997

**C. Description of monument for corner and accessories established to perpetuate locating the position of the corner:**

Found Pipe is accepted as the best available evidence of the position of the original corner. Replaced found pipe with a standard Harrison Monument, Accessories:

- "PK" Nail in Southeasterly side Tw. 12" Cherry N. 35° E. 108.39'
- "PK" Nail in South side 24" Oak East 32.07'
- Nail & Tab in Southwesterly side 14" Elm S. 50° E. 54.93'
- Nail & Tab in North side Utility Pole West 25.62'



Signed by Allen H. McMachen  
 Surveyor's Michigan License No. 16935

Date 5/15/97