

SURVEY & REMONUMENTATION

JUL 23 1997

COMMISSION

LAND CORNER RECORDATION CERTIFICATE Filing Requirement of Act 74, Mich. P.A. 1970

For corners in Richland Twp.
Kalamazoo
(County)

Located In:


Corner Code #

1. Public Land Survey	T	<u>1S.</u>	R	<u>10W.</u>	<u>C-9</u>
	T	_____	R	_____	_____
	T	_____	R	_____	_____
	T	_____	R	_____	_____
2. Property Controlling in Section	S	_____	T	_____	R
	S	_____	T	_____	R
3. Miscellaneous Property in Section	S	_____	T	_____	R
	S	_____	T	_____	R

LIBER 2 PAGE 134
97 MAY 16 PM 3 50
STATE OF MICHIGAN
COUNTY OF KALAMAZOO
RECEIVED FOR RECORD
J. H. H. H.
CLERK - REGISTER

Register of Deeds Stamp & File Number

4. Lot No. _____, Recorded Plat _____
5. Private Claims _____
6. IWM Job No. 26689

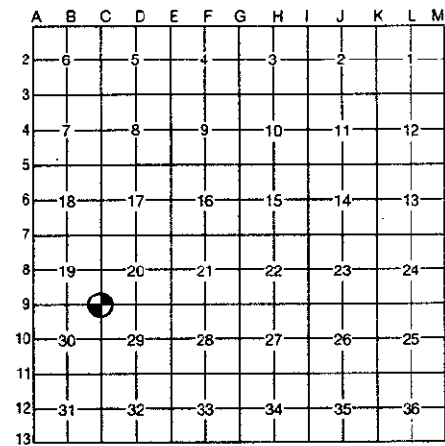

I, Allen H. McMachen, in a field survey on March 31, 19 97, do hereby certify that under requirements of P.A. 74, Michigan P.A. of 1970, the corner points mentioned in lines 1 and 2 above were in conformance with regulations and rules therefore as required in the current manual of survey instructions of the United States Department of the Interior, Bureau of Land Management or by a decree of a Court of Law and/or that the corner points mentioned in lines 3, 4 and 5 above were in conformance with the rules of the Michigan Board of Professional Surveyors or by a Decree of a Court of Law; established, re-established, monumented, re-monumented, recovered, found as expressed below:

NOTE: Not more than 4 corners, all in the same town and range, may be recorded on this certificate.

A. Description of original monument and accessories and/or subsequent restoration:

1827 - John Mullett, D.S., "Set post corner to Sec. 19, 20, 29 and 30, Wh. Oak 10" S. 68° W. 31 lks., Wh. Oak 14" S. 70° E. 8 lks."
1887 - F. Hodgman, C.S., "Corner dug out in Road, Both bearing trees of resurvey standing, Set post."

1973 - Ingersoll, Watson & McMachen, Inc., "Found iron rod, 40" Oak North 35.36', 14" Hickory N. 25° E. 39.46', 16" Hickory, S. 45° E. 42.00', 26" Hickory S. 80° W., 56.68' "

B. Description of corner evidence found and/or method applied in restoring or reestablishing corner:

Found iron rod in monument box per 1973 wits. Removed iron and excavated to depth of 4' and probed an additional 2' and found no additional evidence of marker. Area appears to have been cut about 6' for road grade.

**RATIFIED
BY KALAMAZOO COUNTY
REMONUMENTATION
PEER GROUP
4-16-1997**

C. Description of monument for corner and accessories established to perpetuate locating the position of the corner:

Found iron rod is accepted as the best available evidence of the position of the original corner. Replaced found iron with a Standard Harrison Monument, Accessories:

- "PK" Nail in Southerly side Tw. 24" Maple N. 75° E. 103.93'
- Nail & Tab (found) in Northerly side 24" Hickory S. 70° W. 56.83'
- Nail & Tab (found) in East side 8" Elm North 33.88'
- Nail & Tab (found) in Westerly side 18" Hickory N. 30° E. 39.07'



R. E. S.

Signed by Allen H. McMachen
Surveyor's Michigan License No. 16935

Date 5/15/97