

SURVEY & REMONUMENTATION

AUG 06 1996

1
2 COMMISSION

LAND CORNER RECORDATION CERTIFICATE
Filing Requirement of Act 74, Mich. P.A. 1970

For corners in Kalamazoo Located In: _____ Corner Code # _____
(County)

Richland Twp.

- | | | |
|--------------------------------------|------------------------------|-------------|
| 1. Public Land Survey | T <u>1</u> S. R <u>10</u> W. | <u>D-09</u> |
| | T _____ R _____ | _____ |
| | T _____ R _____ | _____ |
| | T _____ R _____ | _____ |
| 2. Property Controlling in Section | S _____ T _____ R _____ | _____ |
| | S _____ T _____ R _____ | _____ |
| 3. Miscellaneous Property in Section | S _____ T _____ R _____ | _____ |
| | S _____ T _____ R _____ | _____ |

4. Lot No. _____, Recorded Plat _____
5. Private Claims _____


STATE OF MICHIGAN
COUNTY OF KALAMAZOO
RECEIVED FOR RECORD
96 MAY 23 PM 1 47
Clerk-Register
[Signature]

LIBER 2 PAGE 001

Register of Deeds Stamp & File Number

I, Robert E. Snell, in a field survey on April 30, 1996, do hereby certify that under requirements of P.A. 74, Michigan P.A. of 1970, the corner points mentioned in lines 1 and 2 above were in conformance with regulations and rules therefore as required in the current manual of survey instructions of the United States Department of the Interior, Bureau of Land Management or by a decree of a Court of Law and/or that the corner points mentioned in lines 3, 4 and 5 above were in conformance with the rules of the Michigan Board of Professional Surveyors or by a Decree of a Court of Law; established, re-established, monumented, re-monumented, recovered, found as expressed below:

NOTE: Not more than 4 corners, all in the same town and range, may be recorded on this certificate.

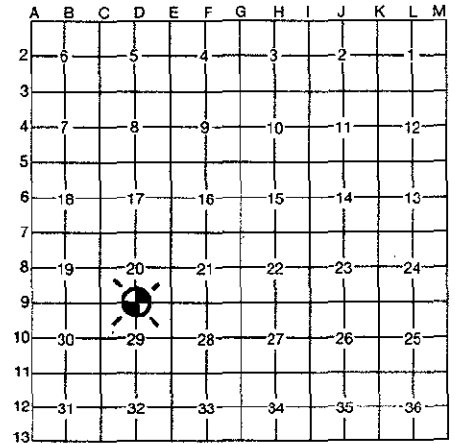

A. Description of original monument and accessories and/or subsequent restoration:

- 1826: United States Government Surveyors; set 1/4 post common to Sections 20 and 29.
Wh. Oak 12" S. 73° W. 6 lks.
Wh. Oak 7" N. 10° E. 66 lks.
- 1887: F. Hodgman, County Surveyor; found stone of resurvey, set post.
Wh. Oak 16" South 59 lks.
Y. Oak 6" S. 70° W. 109 lks.

B. Description of corner evidence found and/or method applied in restoring or reestablishing corner:

- 1966: Wayland D. Ingersoll; found tile 18" deep placed 1/2" iron over tile.
20" Hickory North 26.0'
20" Ash N. 45° E. 52.1'
12" Ash N. 50° W. 53.7'
8" Hickory S. 45° W. 35.2'
- 1996: Found 1/2" x 18" iron bar over tile in monument box. Tile is 18" deep, center line road is North 2.8' ±.

RATIFIED
BY KALAMAZOO COUNTY
REMONUMENTATION
PEER GROUP
5-16-1996 *[Signature]*

C. Description of monument for corner and accessories established to perpetuate locating the position of the corner:

- D-09: South 1/4 post Section 20, T. 1 S., R. 10 W.; Ratified by the Kalamazoo County Remonumentation Program Peer Group on May 16, 1996 and is accepted as a careful and faithful perpetuation of the position of the original corner. Found 3" round tile with cross in top as set by F. Hodgman, County Surveyor in a remonumentation survey in 1887 inside a monument box. Set 18" Harrison Monument over tile in monument box.
- | | | |
|-------------------------------------|-----------|--------|
| PK Nail on East Side of 30" Hickory | N. 2° E. | 25.61' |
| PK Nail in South Root of 42" Ash | N. 60° E. | 51.50' |
| PK Nail on West Side of 22" Cherry | S. 18° E. | 26.05' |
| PK Nail on East Side of 22" Hickory | S. 45° W. | 34.43' |

Signed by *Robert E. Snell*
Surveyor's Michigan License No. 9734

Date 5-23-96