

**SURVEY & REMONUMENTATION**

APR 27 1995

**COMMISSION**

**LAND CORNER RECORDATION CERTIFICATE**  
Filing Requirement of Act 74, Mich. P.A. 1970

STATE OF MICHIGAN  
COUNTY OF KALAMAZOO  
RECEIVED FOR RECORD

JAN 17 PM 12 39 '95

*[Signature]*  
CLERK-REGISTER

CLERK-REGISTER

LIBER 1 PG 1261

Register of Deeds Stamp & File Number

For corners in

Kalamazoo

(County)

Richland Township

Located In:

Corner Code --//

1. Public Land Survey	T <u>1</u> S R <u>10</u> W	<u>E-6</u>
	T _____ R _____	_____
	T _____ R _____	_____
	T _____ R _____	_____
2. Property Controlling in Section	S _____ T _____ R _____	_____
	S _____ T _____ R _____	_____
3. Miscellaneous Property in Sec.	S _____ T _____ R _____	_____
	S _____ T _____ R _____	_____

4. Lot No. \_\_\_\_\_, Recorded Plat \_\_\_\_\_  
5. Private Claims \_\_\_\_\_

I, Robert E. Snell, in a field survey on May 31, 19 94, do hereby certify that under requirements of P.A. 74, Michigan P.A. of 1970, the corner points mentioned in lines 1 and 2 above were in conformance with regulations and rules therefore as required in the current manual of survey instructions of the United States Department of the Interior, Bureau of Land Management or by a decree of a Court of Law and/or that the corner points mentioned in lines 3, 4 and 5 above were in conformance with the rules of the Michigan Board of Land Surveyors or by a Decree of a Court of Law; established, re-established, monumented, re-monumented, recovered, found as expressed below:

**NOTE: Not more than 4 corners, all in the same town and range, may be recorded on this certificate.**

A. Description of original monument and accessories and/or subsequent restoration:

1826: U.S. Government Survey; Set 1/4 Section Post.

Hickory 7" South 19° East 13 Lks  
Hickory 12" North 43° East 27 Lks


1887: F.Hodgman, County Surveyor; Found stone of resurvey in Road in line with Fence East. Set Post.

Hickory 12" North 17° West 13 Lks  
Hickory 10" South 86½° East 93 Lks

1981: Ingersoll, Watson, and McMachen, Surveyors; Set iron on bi-section because it hit occupation much better than hold projection or West 1/4 through found Center.

B. Description of corner evidence found and/or method applied in restoring or reestablishing corner:

1994: Found 3" round tile and stone. Iron in monument box was found to be 0.5' North and 6.5' East of tile as found.

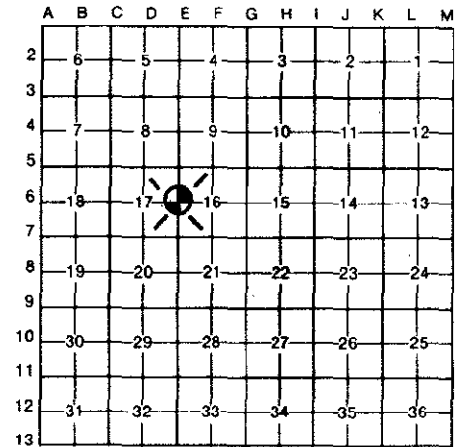

**RATIFIED BY KALAMAZOO COUNTY REMONUMENTATION PEER GROUP**

7/21/94  
*[Signature]*

C. Description of monument for corner and accessories established to perpetuate locating the position of the corner:

E-6 East 1/4 Post Section 17, T. 1 S., R. 10 W., Ratified by the Kalamazoo County Remonumentation Program Peer Group on July 21, 1994. Found 3" round tile as called for in 1887 remonumentation survey by F.Hodgman and is accepted as a careful and faithful perpetuation of the position of the original corner. Removed top section of tile and placed a 20" Harrison monument in monument box over tile.

Centerline of 28th Street	East	2.75'
Existing PK Nail in	22" Hickory North 60° West	31.30'
Existing PK Nail in	20" Hickory South 86° East	22.81'
Existing PK Nail in	20" Hickory South 32° East	37.40'
Existing PK Nail in	10" Hickory South 22° West	56.27'

Signed by *[Signature]* Date 1-17-95

Surveyor's Michigan License No. 9734