

**1**  
**2**  
SURVEY &  
REMONUMENTATION

APR 27 1995

COMMISSION

LAND CORNER RECORDATION CERTIFICATE  
Filing Requirement of Act 74, Mich. P.A. 1970

STATE OF MICHIGAN  
COUNTY OF KALAMAZOO  
RECEIVED FOR RECORD

'94 DEC 15 PM 1 37

For corners in RICHLAND TWP.

<u>KALAMAZOO</u> (County)	Located In:	Corner Code #
1. Public Land Survey	T <u>1</u> S <u>R</u> 10 W	<u>E-7</u>
	T _____ R _____	_____
	T _____ R _____	_____
	T _____ R _____	_____
2. Property Controlling in Section	S _____ T _____ R _____	_____
	S _____ T _____ R _____	_____
3. Miscellaneous Property in Sec.	S _____ T _____ R _____	_____
	S _____ T _____ R _____	_____
4. Lot No. _____, Recorded Plat _____		
5. Private Claims _____		

*Janet [Signature]*  
CLERK-REGISTER

LIBER 1 PG. 1225

Register of Deeds Stamp & File Number

I, Allen H. McMachen a field survey on August 12, 19 94, do hereby certify that under requirements of P.A. 74, Michigan P.A. of 1970, the corner points mentioned in lines 1 and 2 above were in conformance with regulations and rules therefore as required in the current manual of survey instructions of the United States Department of the Interior, Bureau of Land Management or by a decree of a Court of Law and/or that the corner points mentioned in lines 3, 4 and 5 above were in conformance with the rules of the Michigan Board of Land Surveyors or by a Decree of a Court of Law; established, re-established, monumented, re-monumented, recovered, found as expressed below:

**NOTE: Not more than 4 corners, all in the same town and range, may be recorded on this certificate.**

A. Description of original monument and accessories and/or subsequent restoration:


1880's - F. Hodgeman C.S. placed Clay Tile post during official Township Remonumentation.

A	B	C	D	E	F	G	H	I	J	K	L	M
2	6	5	4	3	2	1						
3												
4	7	8	9	10	11	12						
5												
6	18	17	16	15	14	13						
7												
8	19	20	21	22	23	24						
9												
10	30	29	28	27	26	25						
11												
12	31	32	33	34	35	36						
13												

B. Description of corner evidence found and/or method applied in restoring or reestablishing corner:

Found Clay Tile under capped Iron rod in monument box.

RATIFIED  
BY KALAMAZOO COUNTY  
REMONUMENTATION  
PEER GROUP  
8-18-94 *R.C.*

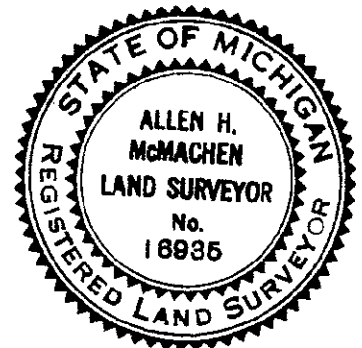

C. Description of monument for corner and accessories established to perpetuate locating the position of the corner:

Found Clay Tile is accepted as a careful and faithful perpetuation of original corner. Removed monument box and Iron rod. Placed Harrison monument over Clay Tile and monument box over.  
Accessories:

- Nail in 10" Hickory SE'ly 71.90'
- Nail in fence post NE'ly 45.35'
- Nail in 10" Oak N. 33° E. 62.82'
- center of 2" Dia. pipe in top of concrete fence post SE'ly 43.18'
- ½" Iron in monument box NW'ly 6.27'

Signed by Allen H. McMachen Date 12/15/94  
Surveyor's Michigan License No. 16935