



LC-000069

Page: 1 of 1

11/18/1999 02:22P

BK-2 Pg-522

LAND CORNER RECORDATION CERTIFICATE
Filing Requirement of Act 74, Mich. P.A. 1970

For corners in

Kalamazoo

(County)

Richland Township

Located In:

Corner Code#

1. Public Land Survey

T 1S R 10W

E-11

T R
T R
T R
S T R
S T R
S T R
S T R

2. Property Controlling in Section

3. Miscellaneous

Property in Sec.

4. Lot No. , Recorded Plat

5. Private Claims

SURVEY & REMONUMENTATION

FEB 08 2000

SECTION

Register of Deeds Stamp & File Number

I, Gary D. Hahn, in a field survey on November 5, 1999

do hereby state that under requirements of P.A. 74, Michigan P.A. of 1970, the corner points mentioned in lines 1 and 2 above were in conformance with regulations and rules therefore as required in the current manual of survey instructions of the United States Department of the Interior, Bureau of Land Management or by a decree of a Court of Law and /or that the corner points mentioned in lines 3, 4 and 5 above were in conformance with the rules of the Michigan Board of Land Surveyors or by a Decree of a Court of Law; established, re-established, monumented, recovered, found as expressed below:

NOTE: Not more than 2 corners, all in the same town and range, may be recorded on this certificate.

A. Description of original monument and accessories and/or subsequent restoration:

See previously recorded land corner recordation certificate Liber 1, Page 1488. This corner was ratified by the Kalamazoo County Remonumentation Peer Group on April 18, 1996.

B. Description of corner evidence found and/or method applied in restoring or reestablishing corner:

Found a clay tile with a remonumentation sleeve over it in a monument box. The monument box was removed during milling operations for the reconstruction of 29th Street. However the monument and sleeve were left in place.

C. Description of monument for corner and accessories established to perpetuate locating the position of the corner:


E-11, Southeast Corner Section 29, Town 1 South, Range 10 West. Ratified by Kalamazoo County Remonumentation Peer Group on April 18, 1996. The position of the found clay tile was accepted as a careful and faithful perpetuation of the position of the original corner. Set a 20" Harrison Monument in a Monument Box directly over the clay tile.

Witness Ties:

- Set Mag nail in 18" Oak N 50° E 50.82'
Found a 5/8" rebar in concrete East 33.10'
Set a Mag nail in fence post S 45° E 47.81'
Found PK nail in North side of wood fence corner S 80° E 31.70'
Found PK nail in North side of 24" Oak S 82° W 99.47'

Grid table with columns A-L and rows 1-13. A black dot is located at the intersection of column E and row 11.

RATIFIED BY KALAMAZOO COUNTY REMONUMENTATION PEER GROUP 4-18-1996

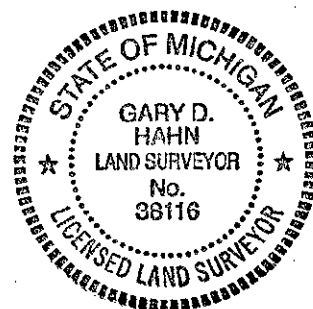

Signed by [Signature] Surveyor's Michigan License No. 38116

Date 11/8/99

FORM APPROVED BY MICHIGAN STATE BOARD OF PROFESSIONAL SURVEYORS,

JAN. 28, 1971

REVISED MAY 14, 1975
REVISED JAN., 1983 REVISED OCT., 1995