

SURVEY & REMONUMENTATION

AUG 06 1996

COMMISSION

LAND CORNER RECORDATION CERTIFICATE
Filing Requirement of Act 74, Mich. P.A. 1970

For corners in
Kalamazoo
(County)
Richland Twp.

Located In:

Corner Code #

- | | | |
|--------------------------------------|------------------------------|-------------|
| 1. Public Land Survey | T <u>1</u> S. R <u>10</u> W. | <u>F-07</u> |
| | T _____ R _____ | _____ |
| | T _____ R _____ | _____ |
| | T _____ R _____ | _____ |
| 2. Property Controlling in Section | S _____ T _____ R _____ | _____ |
| | S _____ T _____ R _____ | _____ |
| 3. Miscellaneous Property in Section | S _____ T _____ R _____ | _____ |
| | S _____ T _____ R _____ | _____ |


STATE OF MICHIGAN
 COUNTY OF KALAMAZOO
 RECEIVED FOR RECORD
 96 JUN 7 PM 2 27
 CLERK - REGISTER

LIBER 2 PAGE 032

Register of Deeds Stamp & File Number

4. Lot No. _____, Recorded Plat _____
 5. Private Claims _____

I, Robert E. Snell, in a field survey on March 1, 1996, do hereby certify that under requirements of P.A. 74, Michigan P.A. of 1970, the corner points mentioned in lines 1 and 2 above were in conformance with regulations and rules therefore as required in the current manual of survey instructions of the United States Department of the Interior, Bureau of Land Management or by a decree of a Court of Law and/or that the corner points mentioned in lines 3, 4 and 5 above were in conformance with the rules of the Michigan Board of Professional Surveyors or by a Decree of a Court of Law; established, re-established, monumented, re-monumented, recovered, found as expressed below:

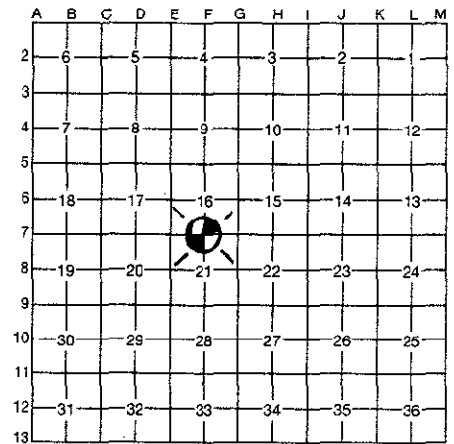

NOTE: Not more than 4 corners, all in the same town and range, may be recorded on this certificate.

A. Description of original monument and accessories and/or subsequent restoration:

- 1826: United States Government Surveyors; set 1/4 Section post.
 Wh. Oak 16" S. 85° W. 80 lks.
 Hickory 10" S. 25° E. 114 lks.
- 1887: F. Hodgman, County Surveyor; found stake S. 48° W. 58 lks. from Red Oak 30" bearing tree.
 Burr Oak 9" S. 51½° E. 61 lks.

B. Description of corner evidence found and/or method applied in restoring or reestablishing corner:

- 1957: Wilkins & Wheaton Engineering Co.; found tile 4' deep, placed iron over tile.
 8" Maple N. 70° E. 78.3' Fence to South 1' East
 16" Quad. Oak S. 65° E. 71.2' Fence to North 33.3' West
 30" Elm S. 10° E. 36.3'
- 1996: Found 3/4" x 54" long iron bar over and along side of tile 40" deep.

RATIFIED
BY KALAMAZOO COUNTY
REMONUMENTATION
PEER GROUP
 3-21-1996

C. Description of monument for corner and accessories established to perpetuate locating the position of the corner:

- F-07: South 1/4 post of Section 16, T. 1 S., R. 10 W., ratified by the Kalamazoo County Remonumentation Program Peer Group on March 21, 1996, and is accepted as a careful and faithful perpetuation of the position of the original corner. Found 3" round tile as set by F. Hodgman, County Surveyor in 1887 remonumentation survey. Placed 20" Harrison monument at surface in monument box.
- Nail and Tab on West Side of Railroad tie fence corner S. 08° E. 23.35'
 PK Nail on Northwest Side of 22" Maple S. 77° W. 46.52'
 PK Nail on Southwest Side of 18" Elm N. 20° W. 62.13'
 PK Nail on East Side of 10" Elm N. 10° W. 51.08'

Signed by Robert E. Snell
 Surveyor's Michigan License No. 9734

Date 6-6-96