

APR 01 1996

STATE OF MICHIGAN  
COUNTY OF KALAMAZOO  
RECEIVED FOR RECORD

COMMISSION LAND CORNER RECORDATION CERTIFICATE

Filing Requirement of Act 74, Mich. P.A. 1970 '95 JAN 23 PM 3 50

For corners in

Kalamazoo  
(County)

Located In:

Corner Code #

Richland Twp.


1. Public Land Survey	T	1	S.	R	10	W.	H-09
	T			R			
	T			R			
	T			R			
2. Property Controlling in Section	S		T		R		
	S		T		R		
3. Miscellaneous Property in Section	S		T		R		
	S		T		R		

*James D. Young*  
CLERK - REGISTER

LIBER 1 1433  
Register of Deeds Stamp & File Number

4. Lot No. \_\_\_\_\_, Recorded Plat \_\_\_\_\_  
5. Private Claims \_\_\_\_\_

I, Robert E. Snell, in a field survey on December 6, 1995, do hereby certify that under requirements of P.A. 74, Michigan P.A. of 1970, the corner points mentioned in lines 1 and 2 above were in conformance with regulations and rules therefore as required in the current manual of survey instructions of the United States Department of the Interior, Bureau of Land Management or by a decree of a Court of Law and/or that the corner points mentioned in lines 3, 4 and 5 above were in conformance with the rules of the Michigan Board of Professional Surveyors or by a Decree of a Court of Law; established, re-established, monumented, re-monumented, recovered, found as expressed below:

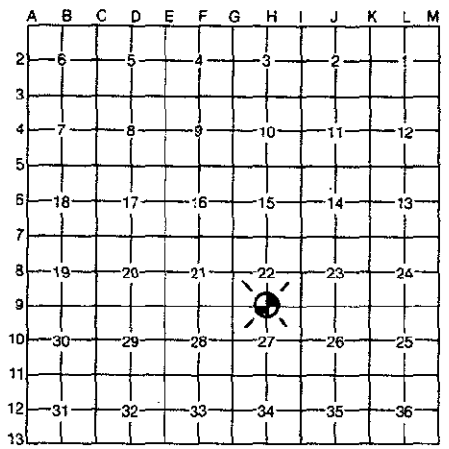

NOTE: Not more than 4 corners, all in the same town and range, may be recorded on this certificate.

A. Description of original monument and accessories and/or subsequent restoration:  
1826: United States Government Surveyors; set post and raised mound in prairie.  
1887: F. Hodgman, County Surveyor; found cedar stake in mound at intersection of fences. Set post.

B. Description of corner evidence found and/or method applied in restoring or reestablishing corner:  
1995: Found tile in East and West fence line.

RATIFIED  
BY KALAMAZOO COUNTY  
REMONUMENTATION  
PEER GROUP  
12-14-95  
*R.E.S.*

C. Description of monument for corner and accessories established to perpetuate locating the position of the corner:  
H-09: South 1/4 post Section 22, T. 1 S., R. 10 W., Ratified by the Kalamazoo County Remonumentation Program Peer Group on December 14, 1995 and is accepted as a careful and faithful perpetuation of the position of the original corner. Found 3" round tile with "x" on top as called for in 1887 remonumentation survey by F. Hodgman, placed remonumentation sleeve over tile.

In East and West fence line.  
Fence line to South. West 10.70'  
Center Line 16" Cherry S. 10° W. 47.30'  
Center Line 24" Cherry N. 40° W. 8.20'

Signed by *Robert E. Snell* Date 1-18-96  
Surveyor's Michigan License No. 9734