

APR 01 1996

KALAMAZOO COUNTY REMONUMENTATION

STATE OF MICHIGAN
COUNTY OF KALAMAZOO
RECEIVED FOR RECORD

COMMISSION

LAND CORNER RECORDATION CERTIFICATE

Filing Requirement of Act 74, Mich. P.A. 1970

'95 NOV 17 AM 9 37

For corners in

KALAMAZOO
(County)

Located In:

Corner Code #

1. Public Land Survey	T <u>1S</u>	R <u>10W</u>	<u>1-1</u>
	T _____	R _____	_____
RICHLAND TOWNSHIP CORNER COMMON TO SECTIONS 2 AND 3 ON BASE LINE	T _____	R _____	_____
	T _____	R _____	_____
2. Property Controlling in Section	S _____	T _____	R _____
	S _____	T _____	R _____
3. Miscellaneous Property in Sec.	S _____	T _____	R _____
	S _____	T _____	R _____

Janet Jones

CLERK-REGISTER

LIBER **1 1373**

Register of Deeds Stamp & File Number

- 4. Lot No. _____, Recorded Plat _____
- 5. Private Claims _____

BRIAN REYNOLDS

OCTOBER 24

95

I, _____, in a field survey on _____, 19 _____, do hereby certify that under requirements of P.A. 74, Michigan P.A. of 1970, the corner points mentioned in lines 1 and 2 above were in conformance with regulations and rules therefore as required in the current manual of survey instructions of the United States Department of the Interior, Bureau of Land Management or by a decree of a Court of Law and/or that the corner points mentioned in lines 3, 4 and 5 above were in conformance with the rules of the Michigan Board of Land Surveyors or by a Decree of a Court of Law; established, re-established, monumented, re-monumented, recovered, found as expressed below:

NOTE: Not more than 4 corners, all in the same town and range, may be recorded on this certificate.

A	B	C	D	E	F	G	H	I	J	K	L	M
2	6	5	4	3	2	1						
3												
4	7	8	9	10	11	12						
5												
6	18	17	16	15	14	13						
7												
8	19	20	21	22	23	24						
9												
10	30	29	28	27	26	25						
11												
12	31	32	33	34	35	36						
13												

A. Description of original monument and accessories and/or subsequent restoration:


- 1. CORNER ESTABLISHED BY GENERAL LAND OFFICE DEPUTY SURVEYOR JOHN MULLETT, 1826, "84.90 INTERSECTED BASE LINE 150 LKS W OF QR. SEC POST. SET POST AT INTERSECTION. COR SECS. 2 & 3 WH. OAK 14 IN S51E LKS DIST Do. 7 IN S20W 41LKS" VOL5, P178
- 2. F. HODGEMAN, COUNTY SURVEYOR, SURVEY FOR HIGHWAY, JUNE 12 & 13, 1877, VOL 2, P 179 "FROM 1 WITNESS FOUND STAKE & BRICK MAPLE 12" S69 1/2W 120 1/2 CHERRY 12" N88°W 147 NOT MARKED"
- 3. HODGEMAN (SAME VOLUME AND PAGE) SURVEY FOR TOWNSHIP OF RICHLAND, SEPT. 15, 1887, "SEE ABOVE SET POST"
- 4. LAND CORNER RECORDATION CERTIFICATE, L1, P825, GREGORY G. SMITH, PS#19844, RECORDED OCT. 14, 1981, "FOUND TILE 1' UNDER SURFACE OF N. SIDE GRAVEL ROAD AS PER COUNTY SURVEYOR WITNESSES. SET LARGE NAIL AT SURFACE." LARGE NAIL OVER TILE; NORTH SIDE OF GRAVEL ROAD; CONC FENCE POST, S.W. 45.78; 36" BASSWOOD STUMP, WEST, 96'; 8" ELM STUMP, NORTH, 25.9'

B. Description of corner evidence found and/or method applied in restoring or reestablishing corner:

FOUND LARGE NAIL AND WITNESSES FROM LCRC LIBER 1, PAGE 825. EXCAVATED BELOW LARGE NAIL, FOUND 3" SOLID TILE. ACCEPTED AS PROPER PERPETUATION OF CORNER POSITION. PLACED IRON SLEEVE OVER TILE.

R.R.S.

**RATIFIED
BY KALAMAZOO COUNTY
REMONUMENTATION
PEER GROUP
11-16-95**

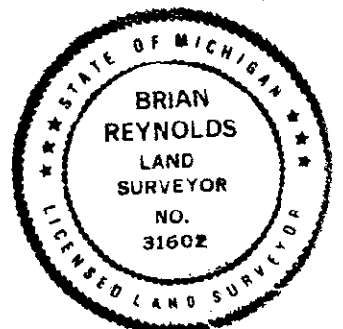

C. Description of monument for corner and accessories established to perpetuate locating the position of the corner:

WITNESSES TO IRON SLEEVE OVER TILE:

- BARRY COUNTY REMONUMENT (J-13 T1N R10W) (3/4"X24" IRON IN HOLLOW TILE) EAST 94.84'
- NAIL & TAG IN N SIDE OF RAILROAD TIE CORNER FENCE POST S89°E 90.10'
- NAIL & TAG IN SE SIDE OF UTILITY POLE N51°E 23.20'
- NAIL & TAG IN N SIDE OF 22" OAK S72°W 89.62'
- CENTER OF SQUARE TOP OF 12"X12" CONCRETE POST S40°W 46.07'
- CENTERLINE OF GRAVEL ROAD TO WEST SOUTH 11.5+/-
- CENTERLINE OF BITUMINOUS N-S ROAD EAST 54+/-

Signed by

[Signature]

Date

Nov. 16, 1995

Surveyor's Michigan License No.

31602

