

NOV 1995

CERTIFICATION

STATE OF MICHIGAN
COUNTY OF KALAMAZOO
RECEIVED FOR RECORD

LAND CORNER RECORDATION CERTIFICATE
Filing Requirement of Act 74, Mich. P.A. 1970

95 AUG 25 PM 3 51

For corners in


<u>Kalamazoo</u> <small>(County)</small>	Located In:	Corner Code #
<u>Richland Township</u>		
1. Public Land Survey	T <u>1</u> S R <u>10</u> W	<u>K-2</u>
	T _____ R _____	_____
	T _____ R _____	_____
	T _____ R _____	_____
2. Property Controlling in Section	S _____ T _____ R _____	_____
	S _____ T _____ R _____	_____
3. Miscellaneous Property in Sec.	S _____ T _____ R _____	_____

Jessie J. ...
CLERK-REGISTER

LIBER 1 ■ 1330

Register of Deeds Stamp & File Number

- 4. Lot No. _____, Recorded Plat _____
- 5. Private Claims _____

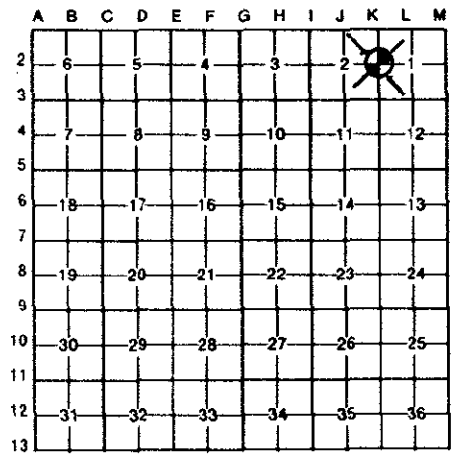

I, Robert E. Snell, in a field survey on March 2, 19 94, do hereby certify that under requirements of P.A. 74, Michigan P.A. of 1970, the corner points mentioned in lines 1 and 2 above were in conformance with regulations and rules therefore as required in the current manual of survey instructions of the United States Department of the Interior, Bureau of Land Management or by a decree of a Court of Law and/or that the corner points mentioned in lines 3, 4 and 5 above were in conformance with the rules of the Michigan Board of Land Surveyors or by a Decree of a Court of Law; established, re-established, monumented, re-monumented, recovered, found as expressed below:

NOTE: Not more than 4 corners, all in the same town and range, may be recorded on this certificate.

A. Description of original monument and accessories and/or subsequent restoration:
1826: United States Government Survey; Set 1/4 Section Post.
Ironwood 8" South 10° West 8 Lks
Wh. Oak 10" North 18° West 27 Lks

1877: F. Hodgman, County Surveyor; Found stone and one witness standing.
1887: F. Hodgman, County Surveyor; Found stone South 18° East, 27 Lks from White Oak Bearing Tree. Set Post.

B. Description of corner evidence found and/or method applied in restoring or reestablishing corner:
1994: Found 3" Round Tile.

RATIFIED
BY KALAMAZOO COUNTY
REMONUMENTATION
PEER GROUP
5-18-95
R. E. S.

C. Description of monument for corner and accessories established to perpetuate locating the position of the corner:
K-2 West 1/4 Post Section 1, T. 1 S., R. 10 W., Ratified by the Kalamazoo County Remonumentation Program Peer Group on May 18, 1995 and is accepted as a careful and faithful perpetuation of the position of the original corner. Found 3" Round Tile as called for in 1887 remonumentation survey by F. Hodgman. Placed remonumentation sleeve over tile.

PK nail in West Side	18" Hickory	North 28° East 40.19'	Tile is 238' North
Southeast Corner	Concrete House Foundation	North 54° East 68.47'	of Centerline
PK Nail in South Side	26" Oak	South 74° East 53.98'	Stedman Drive
PK Nail in South Side	6" Oak	South 78° West 45.20'	
	3/4" Iron	South 0.7'	

Signed by *Robert E. Snell* Date 8-22-95
Surveyor's Michigan License No. 9734