

**SURVEY & REMONUMENTATION**

1  
2  
OCT 06 1997

COMMISSIONER

**LAND CORNER RECORDATION CERTIFICATE**  
Filing Requirement of Act 74, Mich. P.A. 1970

For corners in Richland Twp.  
Kalamazoo  
(County)

Located In:

Corner Code #

- |                                      |   |            |   |             |             |
|--------------------------------------|---|------------|---|-------------|-------------|
| 1. Public Land Survey                | T | <u>1S.</u> | R | <u>10W.</u> | <u>K-12</u> |
|                                      | T | _____      | R | _____       | _____       |
|                                      | T | _____      | R | _____       | _____       |
|                                      | T | _____      | R | _____       | _____       |
| 2. Property Controlling in Section   | S | _____      | T | _____       | _____       |
|                                      | S | _____      | T | _____       | _____       |
| 3. Miscellaneous Property in Section | S | _____      | T | _____       | _____       |
|                                      | S | _____      | T | _____       | _____       |

4. Lot No. \_\_\_\_\_, Recorded Plat \_\_\_\_\_  
5. Private Claims \_\_\_\_\_

I, Allen H. McMachen, in a field survey on June 4, 19 97, do hereby certify that under requirements of P.A. 74, Michigan P.A. of 1970, the corner points mentioned in lines 1 and 2 above were in conformance with regulations and rules therefore as required in the current manual of survey instructions of the United States Department of the Interior, Bureau of Land Management or by a decree of a Court of Law and/or that the corner points mentioned in lines 3, 4 and 5 above were in conformance with the rules of the Michigan Board of Professional Surveyors or by a Decree of a Court of Law; established, re-established, monumented, re-monumented, recovered, found as expressed below:

**NOTE: Not more than 4 corners, all in the same town and range, may be recorded on this certificate.**

**A. Description of original monument and accessories and/or subsequent restoration:**

1826 - John Mullett, D.S.  
Set quarter Section post, Wh. Oak 15" S. 39° W. 22 lks.  
Wh. Oak 16" N. 62° E. 35 lks.

1887 - F. Hodgman, C.S., "Found old stake hole at intersection of fences on line with and midway between Section corners. Set post. Hickory 6" West 15 lks." D.O. 10" East 15½ lks.

**B. Description of corner evidence found and/or method applied in restoring or reestablishing corner:**


Found clay tile per both of Hodgman's 1887 witnesses. Tile is 2 feet South of East and West fence and ±193 feet West of fence to South.

**C. Description of monument for corner and accessories established to perpetuate locating the position of the corner:**

Found clay tile is accepted a careful and faithful perpetuation of the position of the original corner. Placed Standard Sleeve over found clay tile, Accessories:

- Nail & Tab in South side 34" Hickory West 10.50' (Hodgman)
- Nail & Tab in South side 33" Hickory East 11.0' (Hodgman)
- Nail & Tab in West side 7" Oak South 64.65'
- Nail & Tab in Northeasterly side 24" Triple Mulberry S. 25° W. 62.48'

**RATIFIED**  
**BY KALAMAZOO COUNTY**  
**REMONUMENTATION**  
**PEER GROUP**  
6-19-1997 *R.E.S.*

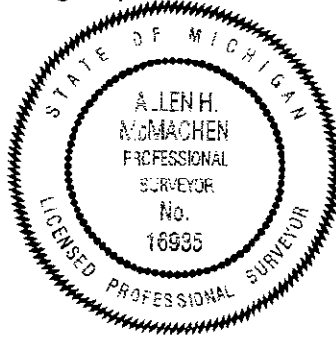

Signed by Allen H. McMachen  
Surveyor's Michigan License No. 16935

Date 7/14/97

A	B	C	D	E	F	G	H	I	J	K	L	M
2	6	5	4	3	2	1						
3												
4	7	8	9	10	11	12						
5												
6	18	17	16	15	14	13						
7												
8	19	20	21	22	23	24						
9												
10	30	29	28	27	26	25						
11												
12	31	32	33	34	35	36						
13												

STATE OF MICHIGAN  
COUNTY OF KALAMAZOO  
RECEIVED FOR RECORD  
97 JUL 29 PM 3 57  
CLERK - REGISTER  
*Janet Johnson*  
LIBER 2PAGE 179

Register of Deeds Stamp & File Number