

SURVEY & REMONUMENTATION

MAY 28 1997

COMMISSION

LAND CORNER RECORDATION CERTIFICATE
Filing Requirement of Act 74, Mich. P.A. 1970

For corners in


<u>Kalamazoo</u>	Located In:	Corner Code #
Cooper (County) Twp.		
1. Public Land Survey	T <u>1S</u> R <u>11W</u>	<u>B-05</u>
	T <u> </u> R <u> </u>	<u> </u>
	T <u> </u> R <u> </u>	<u> </u>
	T <u> </u> R <u> </u>	<u> </u>
2. Property Controlling in Section	S <u> </u> T <u> </u> R <u> </u>	<u> </u>
	S <u> </u> T <u> </u> R <u> </u>	<u> </u>
3. Miscellaneous Property in Sec.	S <u> </u> T <u> </u> R <u> </u>	<u> </u>
	S <u> </u> T <u> </u> R <u> </u>	<u> </u>

STATE OF MICHIGAN
COUNTY OF KALAMAZOO
RECEIVED FOR RECORD
96 OCT 18 AM 11 32
CLERK - REGISTER
[Signature]
LIBER 2 PAGE 062
Register of Deeds Stamp & File Number

4. Lot No. _____, Recorded Plat _____
5. Private Claims _____

I, Robert E. Snell, in a field survey on March 8, 19 96 do hereby state that under requirements of P.A. 74, Michigan P.A. of 1970, the corner points mentioned in lines 1 and 2 above were in conformance with regulations and rules therefore as required in the current manual of survey instructions of the United States Department of the Interior, Bureau of Land Management or by a decree of a Court of Law and/or that the corner points mentioned in lines 3, 4 and 5 above were in conformance with the rules of the Michigan Board of Land Surveyors or by a Decree of a Court of Law, established, re-established, monumented, recovered, found as expressed below:

NOTE: Not more than 2 corners, all in the same town and range, may be recorded on this certificate.

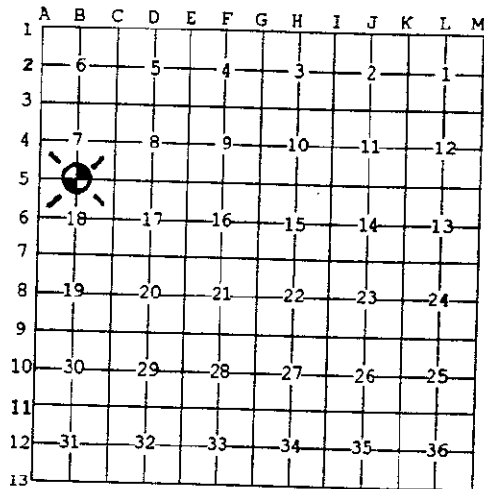

- A. Description of original monument and accessories and/or subsequent restoration:
- 1827: United States Government Surveyors; set 1/4 Section post.
W. Oak 8" N. 82° E. 76 lks.
Y. Oak 16" S. 42° W. 53 lks.
 - 1870: F. Hodgman, County Surveyor; found 1/4 Section corner stake from stumps of two witnesses. Planted stake and marked stone.
Hickory 10" N. 16½° E. 29 lks. Hickory 10" S. 10½° E. 51 lks.
 - 1888: Ed Strong, County Surveyor; North 1/4 post, Section 18, found stone/brick.
Hickory 12" S. 15°+ E. 5 lks.

- B. Description of corner evidence found and/or method applied in restoring or reestablishing corner:
- 1974: Wilkins & Wheaton Engr. Co.; South 1/4 post Section 7, Cooper, bound box.
 - 1976: A. McMachen, R.L.S. #16935; L.C.R.C. L-1, P-724, stone in monument box.
10" Sassafras N. 10° E. 38.62'
20" Poplar S. 30° W. 32.28'
Twin 8" W. Cherry S. 30° E. 22.70'
 - 1996: Found stone in monument box 12" below surface 2.5' South of center line.

RATIFIED
BY KALAMAZOO COUNTY
REMONUMENTATION
PEER GROUP
6-20-1996

- C. Description of monument for corner and accessories established to perpetuate locating the position of the corner:
- B-05: South 1/4 post Section 7, T. 1 S., R. 11 W., ratified by the Kalamazoo County Remonumentation Program Peer Group on June 20, 1996 and is accepted as a careful and faithful perpetuation of the position of the original corner. Found stone as set by F. Hodgman, County Surveyor in 1870 survey down 12" in a monument box. Placed 10" of 20" Harrison monument set in concrete in monument box.
PK Nail over Nail/Tab in West side 18" W. Cherry N. 20° E. 38.79'
PK Nail in West side Twin 15" W. Cherry S. 22° E. 27.25'
PK Nail over Nail/Tab in West side 24" Ash S. 34° W. 32.40'
PK Nail in West side 26" Oak S. 50° W. 57.22'

Signed by *Robert E. Snell* Date 10-14-96
Surveyor's Michigan License No. 9734