

MAY 16 1996

COMMISSION

LIBER

PAGE 1465

LAND CORNER RECORDATION CERTIFICATE

Filing Requirement of Act 74, Mich. P.A. 1970

For corners in Cooper Township Kalamazoo (County)

Located In:

Corner Code #


Table with 4 columns: Item, Direction (T/S), Distance, and Corner Code #. Includes entries for Public Land Survey, Property Controlling in Section, and Miscellaneous Property in Section.

Handwritten signature of the Register of Deeds.

STATE OF MICHIGAN COUNTY OF KALAMAZOO RECEIVED FOR RECORD '96 APR 19 AM 10 29

Register of Deeds Stamp & File Number

- 4. Lot No.
5. Private Claims
6. IWM Job #'s 24071, 24991, 27425, 27585

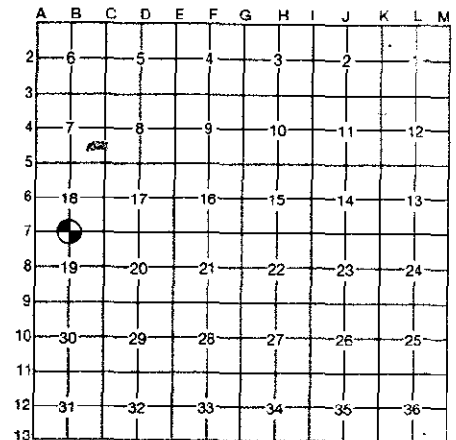

I, Allen H. McMachen, in a field survey on January, 19 96, do hereby certify that under requirements of P.A. 74, Michigan P.A. of 1970, the corner points mentioned in lines 1 and 2 above were in conformance with regulations and rules therefore as required in the current manual of survey instructions of the United States Department of the Interior, Bureau of Land Management or by a decree of a Court of Law and/or that the corner points mentioned in lines 3, 4 and 5 above were in conformance with the rules of the Michigan Board of Professional Surveyors or by a Decree of a Court of Law; established, re-established, monumented, re-monumented, recovered, found as expressed below:

NOTE: Not more than 4 corners, all in the same town and range, may be recorded on this certificate.

A. Description of original monument and accessories and/or subsequent restoration:

- 1827 - John Mullet, D.S., Set quarter Section post, Y. Oak 24" S. 31° E. 27 lks., Y. Oak 18" N. 30° W. 47 lks.
1869 - F. Hodgman, C.S., at the quarter post on the South side of Section 18 found stone set, verified by stump of one witness Pine 8" S. 40± W. .60 lks., Hickory 8" S. 60° E. 1.44 lks.
1888 - Ed Strong, Dep. Co. Surveyor, found stone all right by record.
1940 - Wilkins & Wheaton, Found stone placed iron above 30" Pine S. 40° W. 39.0', 6" Hickory N. 10° W. 24.0', fence to North is East 20', 24" Pine S. 65° W. 8.31'

B. Description of corner evidence found and/or method applied in restoring or reestablishing corner:

Found iron rod in monument box. Removed iron and box and excavated to depth of 3 feet and found no additional survey marker. Measured from location of found iron to a found iron at NE corner, Section 19 @ 2651.71' (Wilkins 1940 meas. = 2652.76'). Also measured West to found stone at NW corner @ 2507.41' (K.C.R.C. 1961 meas. = 2506.95'). Measured South 5309.51' to found iron at S¼ cor. (Wilkins 1940 meas. = 5311.02)

RATIFIED BY KALAMAZOO COUNTY REMONUMENTATION PEER GROUP 2-15-96

C. Description of monument for corner and accessories established to perpetuate locating the position of the corner:

Found iron rod is accepted as the best available evidence of the position of the corner. Placed Harrison Monument at position of found iron rod and placed monument box over, Accessories:

- Nail & Tab in E. side 6" Sassafras North 36.85'
Nail & Tab in E. side 8" Sassafras N. 10° E., 35.51'
Nail & Tab in W. side 16" Pine South 40.65'
"PK" Nail & Tab in W. side Utility Pole S. 15° W. 66.31'



Signed by Allen H McMachen

Date 4/16/96

Surveyor's Michigan License No. 16935