

APR 01 1996

COMMISSION

LAND CORNER RECORDATION CERTIFICATE  
Filing Requirement of Act 74, Mich. P.A. 1970

STATE OF MICHIGAN  
COUNTY OF KALAMAZOO  
RECEIVED FOR RECORD

'95 DEC 8 AM 10 55

For corners in

KALAMAZOO  
(County)

Located in:

Corner Code #

COOPER TWP.


1. Public Land Survey	T <u>1S</u> R <u>11W</u>	<u>C6</u>
	T _____ R _____	_____
	T _____ R _____	_____
	T _____ R _____	_____
2. Property Controlling in Section	S _____ T _____ R _____	_____
	S _____ T _____ R _____	_____
3. Miscellaneous Property in Section	S _____ T _____ R _____	_____
	S _____ T _____ R _____	_____

*James D. Young*  
CLERK-REGISTER

LIBER 1 1392

Register of Deeds Stamp & File Number

- 4. Lot No. \_\_\_\_\_, Recorded Plat \_\_\_\_\_
- 5. Private Claims \_\_\_\_\_

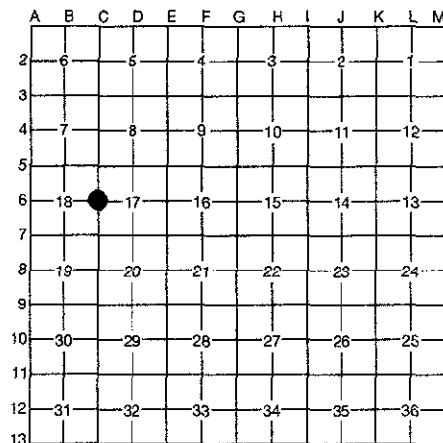

I, Gary D. Hahn, in a field survey on April 28, 19 95, do hereby certify that under requirements of P.A. 74, Michigan P.A. of 1970, the corner points mentioned in lines 1 and 2 above were in conformance with regulations and rules therefore as required in the current manual of survey instructions of the United States Department of the Interior, Bureau of Land Management or by a decree of a Court of Law and/or that the corner points mentioned in lines 3, 4 and 5 above were in conformance with the rules of the Michigan Board of Professional Surveyors or by a Decree of a Court of Law; established, re-established, monumented, re-monumented, recovered, found as expressed below:

**NOTE: Not more than 4 corners, all in the same town and range, may be recorded on this certificate.**

A. Description of original monument and accessories and/or subsequent restoration:

1827 Quarter post established by U.S. Deputy Surveyor John Mullett  
Accessories: Y. Oak 20in S19W 30lk W. Oak 14in N76E 24lk.

1888 E. Strong D.S. "Stone and brick from 1 U.S. stump"  
Y. Oak 6 N37½E 30  
Y. Oak 12 S77½E 50

B. Description of corner evidence found and/or method applied in restoring or reestablishing corner:

Original monument and accessories not recovered.

Fnd. 1/2" bent rebar. Dug beneath and found nothing.

Fnd. 1/2" rod 18" long 10.12' North of bent rebar. Dug down 23" and found many small stones (6" dia.) over a yellow stone with an "X" at its high point. Removed stone but found no brick around. "X" on stone is directly below 1/2" rod.

RATIFIED  
BY KALAMAZOO COUNTY  
REMONUMENTATION  
PEER GROUP  
6-15-95 *R. E. S.*

C. Description of monument for corner and accessories established to perpetuate locating the position of the corner:

C6, East Quarter corner Section 18, T1S, R11W, Ratified by Kalamazoo County Remonumentation Peer Group on June 15, 1995. The position of the stone is accepted as the best available evidence of the position of the original corner. Removed stone and set 20" Harrison monument in monument box.

- Set P.K. nail in 26" Oak N34°W 29.18'
- Set P.K. nail in 27" Twin Oak S30°W 45.92'
- Set P.K. nail in 24" Oak S40°E 29.84'
- Set P.K. nail in 24" Oak N80°E 23.95'



Signed by

*Gary D. Hahn*

Date December 1, 1995

Surveyor's Michigan License No. 38116