

FEB 08 2000

SECTION

LAND CORNER RECORDATION CERTIFICATE  
Filing Requirement of Act 74, Mich. P.A. 1970

For corners in

<u>Kalamazoo</u> (County)	Located In:	Corner Code #
Cooper Township		
1. Public Land Survey	T 1 S R 11 W	C-11
	T _____ R _____	_____
	T _____ R _____	_____
	T _____ R _____	_____
2. Property Controlling in Section	S _____ T _____ R _____	_____
	S _____ T _____ R _____	_____
3. Miscellaneous Property in Sec.	S _____ T _____ R _____	_____
	S _____ T _____ R _____	_____

LC-000007  
Page: 1 of 1  
07/12/1999 10:05A  
BK-2 Pg-460  
CRANE LAND SURVEYING LANDCOR-Kalamazoo

Register of Deeds Stamp & File Number

4. Lot No. \_\_\_\_\_, Recorded Plat \_\_\_\_\_

5. Private Claims \_\_\_\_\_

I, William K. Crane, in a field survey on May 14, 1997 do hereby state that under requirements of P.A. 74, Michigan P.A. of 1970, the corner points mentioned in lines 1 and 2 above were in conformance with regulations and rules therefore as required in the current manual of survey instructions of the United States Department of the Interior, Bureau of Land Management or by a decree of a Court of Law and for that the corner points mentioned in lines 3, 4 and 5 above were in conformance with the rules of the Michigan Board of Land Surveyors or by a Decree of a Court of Law, established, re-established, monumented, recovered, found as expressed below:

A	B	C	D	E	F	G	H	I	J	K	L	M
1												
2	6		5		4		3		2		1	
3												
4	7		8		9		10		11		12	
5												
6	18		17		16		15		14		13	
7												
8	19		20		21		22		23		24	
9												
10	30		29		28		27		26		25	
11												
12	31		32		33		34		35		36	
13												

NOTE: Not more than 2 corners, all in the same town and range, may be recorded on this certificate.

A. Description of original monument and accessories and/or subsequent restoration:

G.L.O., John Mullett, D.S., 1827:	County Survey Records, Volume 6:
9" Beech N 25° E 4 links	8" Hickory N 30° W 44 links
9" D.O. S 13° E 48 links	9" Maple N 27° E 88 links
E. Strong, 1895:	LCRC, McMachen, 1/12/78:
Found iron & brick, set stones over	Iron rod
14" Sugar N 35° E 87 links	27" Maple N 30° W 54.39'
6" W. Oak S 20° E 24 links	U. Pole S 50° W 60.46'
	U. Pole S 40° E 40.72'

B. Description of corner evidence found and/or method applied in restoring or reestablishing corner:


Found 1" iron rod in monument box. Removed iron rod and monument box, dug to a depth of 2.5 feet, found no other markers. Replaced 1" iron with Harrison monument and reset monument box.

C. Description of monument for corner and accessories established to perpetuate locating the position of the corner:

1" iron rod is accepted as the best available evidence of the position of the original corner. Replaced iron with Harrison monument and reset monument box.

30" Maple	N 30° W	55.71'
Utility Pole	S 40° E	42.24'
Utility Pole	S 50° W	60.04'
24" Maple	N 66° W	72.82'

RATIFIED  
BY KALAMAZOO COUNTY  
REMONUMENTATION  
PEER GROUP  
5-4-1999

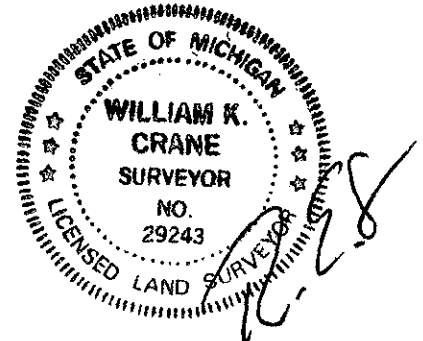

Signed by William K. Crane  
William K. Crane, P.S.  
Surveyor's Michigan License No. 29243

Date July 12, 1999