

SURVEY & REMONUMENTATION

LAND CORNER RECORDATION CERTIFICATE
 Filing Requirement of Act 74, Mich. P.A. 1970

FEB 08 2000

For corners in SECTION

Kalamazoo
 (County)

Located In:

Corner Code #

LC-000006
 Page: 1 of 1
 07/12/1999 10:05A
 Bk-2 Pg-459
 CRANE LAND SURVEYING LANDCOR-Kalamazoo

- Cooper Township
- Public Land Survey T 1 S R 11 W C-12
 T R
 T R
 T R
 - Property Controlling in Section S T R
 S T R
 - Miscellaneous Property in Sec. S T R
 S T R

Register of Deeds Stamp & File Number

- Lot No. _____, Recorded Plat _____
- Private Claims _____

I, William K. Crane, in a field survey on May 29, 1997 do hereby state that under requirements of P.A. 74, Michigan P.A. of 1970, the corner points mentioned in lines 1 and 2 above were in conformance with regulations and rules therefore as required in the current manual of survey instructions of the United States Department of the Interior, Bureau of Land Management or by a decree of a Court of Law and for that the corner points mentioned in lines 3, 4 and 5 above were in conformance with the rules of the Michigan Board of Land Surveyors or by a Decree of a Court of Law; established, re-established, monumented, recovered, found as expressed below:

NOTE: Not more than 2 corners, all in the same town and range, may be recorded on this certificate.

A	B	C	D	E	F	G	H	I	J	K	L	M
1												
2	6	5	4	3	2	1						
3												
4	7	8	9	10	11	12						
5												
6	18	17	16	15	14	13						
7												
8	19	20	21	22	23	24						
9												
10	30	29	28	27	26	25						
11												
12	31	32	33	34	35	36						
13												

A. Description of original monument and accessories and/or subsequent restoration:

G.L.O., John Mullett, D.S., 1827:
 7" Beech N 3° E 41 links
 30" D.O. S 1° W 46 links

Stimson, 1863:
 Buried stone, brick and blacksmith cinders

LCRC, McMachen, 1/12/78:

1" Pipe
 U. Pole N 89° W 79.30'
 U. Pole S 61° W 26.95'
 "T" iron West 33.00'

B. Description of corner evidence found and/or method applied in restoring or reestablishing corner:


Found 1" pipe. Dug 3 feet and removed several stones appearing to be in a pile, but found no other distinct marker. Replaced pipe with Harrison monument and set monument box.

C. Description of monument for corner and accessories established to perpetuate locating the position of the corner:

1" pipe is accepted as the best available evidence of the position of the original corner. Replaced iron with Harrison monument and set monument box.

Utility Pole West 79.50'
 6" Cherry N 10° W 134.02'
 Gate Post N 60° E 32.64'
 "T" iron East 33.00'

RATIFIED
BY KALAMAZOO COUNTY
REMONUMENTATION
PEER GROUP
 5-4-1999

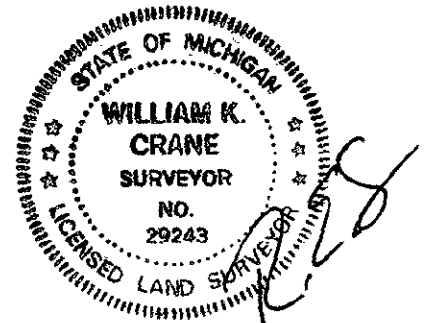

Signed by William K. Crane
 William K. Crane, P.S.

Date July 12, 1999

Surveyor's Michigan License No. 29243