

SURVEY & REMONUMENTATION

7- MAY 28 1997
2-

COMMISSION

LAND CORNER RECORDATION CERTIFICATE
Filing Requirement of Act 74, Mich. P.A. 1970

LIBER

2 PAGE 107

For corners in

<u>Kalamazoo</u> (County)	Located In:	Corner Code #
Cooper Twp.		
1. Public Land Survey	T 1S R 11W	D5
	T R	
	T R	
	T R	
2. Property Controlling in Section	S T R	
	S T R	
3. Miscellaneous Property in Sec.	S T R	
	S T R	

STATE OF MICHIGAN
COUNTY OF KALAMAZOO
RECEIVED FOR RECORD
96 DEC 31 PM 3 21
Jamarcus [Signature]
CLERK - REGISTER

Register of Deeds Stamp & File Number

4. Lot No. _____, Recorded Plat _____
5. Private Claims _____

I, Gary D. Hahn, in a field survey on May 7, 1996 do hereby state that under requirements of P.A. 74, Michigan P.A. of 1970, the corner points mentioned in lines 1 and 2 above were in conformance with regulations and rules therefore as required in the current manual of survey instructions of the United States Department of the Interior, Bureau of Land Management or by a decree of a Court of Law and/or that the corner points mentioned in lines 3, 4 and 5 above were in conformance with the rules of the Michigan Board of Land Surveyors or by a Decree of a Court of Law; established, re-established, monumented, recovered, found as expressed below:

	A	B	C	D	E	F	G	H	I	J	K	L	M
1													
2	6		5		4		3		2		1		
3													
4	7		8		9		10		11		12		
5				●									
6	18		17		16		15		14		13		
7													
8	19		20		21		22		23		24		
9													
10	30		29		28		27		26		25		
11													
12	31		32		33		34		35		36		
13													

NOTE: Not more than 2 corners, all in the same town and range, may be recorded on this certificate.

A. Description of original monument and accessories and/or subsequent restoration:

1827 South quarter corner established by U.S. Deputy Surveyor John Mullet
Accessories: 8" W. Oak North 60 degrees West 28 Links 12" W. Oak South 82 degrees East 39 Links
1870 F. Hodgman: Found sec. cor. stake by digging. Planted stake and stone. 10" Hickory North 60 degrees East 77 10" Cherry South 27 degrees East 52 1/2
Date? KCRC witness notes: 18" Elm South 27.0' 10" W. Cherry South 65 degrees West 64.0' N. road fence North 31.0' Stone 3' below iron above
1959 Gove Associates: Pinched Pipe.


B. Description of corner evidence found and/or method applied in restoring or reestablishing corner:

Original monument and accessories not recovered.
Found 3/4" pinched iron 4" below road surface. Dug further and found a 1" dia. 1.5' long iron pipe directly below pinched iron. Dug further and found a 10" dia. stone with chiseled "X" on top. Stone was 0.11" South and 0.03' East of found iron and pipe.

RATIFIED
BY KALAMAZOO COUNTY
REMONUMENTATION
PEER GROUP
6-20-1996

C. Description of monument for corner and accessories established to perpetuate locating the position of the corner:

D5, South Quarter Post Section 8, Town 1 South, Range 11 West, ratified by Kalamazoo County Remonumentation Peer Group on June 20, 1996. The 12" stone with "X" believed to be same as set by F. Hodgman and is accepted as a careful and faithful perpetuation of the position of the original corner. Removed iron and pipe and set a 20" Harrison Monument in a mon. box over the stone.
Set P.K. nail in 12" Elm North 12 degrees East 29.06'
Set P.K. nail in 8" Elm North 63 degrees West 48.08'
Set P.K. nail in 8" Elm South 2 degrees West 21.67'
Set P.K. nail in 18" Elm South 64 degrees West 47.15'

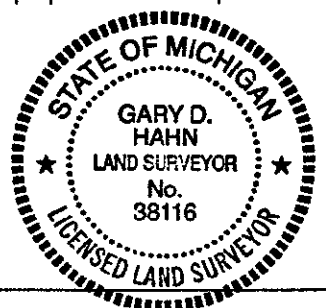

Signed by *Gary D. Hahn*
Surveyor's Michigan License No. 38116

Date 12/28/96