

**LAND CORNER RECORDATION CERTIFICATE**

Filing Requirement of Act 74, Mich. P.A. 1970 '95 AUG 25 PM 3 51

For corners in  
Kalamazoo  
(County)  
Cooper Township

Located In:

Corner Code #

- |                                      |   |            |   |             |            |
|--------------------------------------|---|------------|---|-------------|------------|
| 1. Public Land Survey                | T | <u>1</u> S | R | <u>11</u> W | <u>D-8</u> |
|                                      | T |            | R |             |            |
|                                      | T |            | R |             |            |
|                                      | T |            | R |             |            |
| 2. Property Controlling in Section   | S |            | T | R           |            |
|                                      | S |            | T | R           |            |
| 3. Miscellaneous Property in Section | S |            | T | R           |            |
|                                      | S |            | T | R           |            |


*James J. Jones*  
CLERK-REGISTER

LIBER **1 1333**

Register of Deeds Stamp & File Number

4. Lot No. \_\_\_\_\_, Recorded Plat \_\_\_\_\_  
5. Private Claims \_\_\_\_\_

I, Garth N. Baden, in a field survey on April 24, 19 95, do hereby certify that under requirements of P.A. 74, Michigan P.A. of 1970, the corner points mentioned in lines 1 and 2 above were in conformance with regulations and rules therefore as required in the current manual of survey instructions of the United States Department of the Interior, Bureau of Land Management or by a decree of a Court of Law and/or that the corner points mentioned in lines 3, 4 and 5 above were in conformance with the rules of the Michigan Board of Professional Surveyors or by a Decree of a Court of Law; established, re-established, monumented, re-monumented, recovered, found as expressed below:

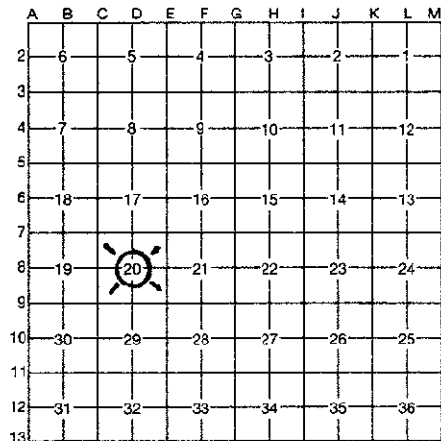

**NOTE: Not more than 4 corners, all in the same town and range, may be recorded on this certificate.**

**A. Description of original monument and accessories and/or subsequent restoration:**

This position not established by original government surveyors.

1864: F. Stimson, County Surveyor; Point on East and West 1/4 Line near Center.

W. Oak 30" South 26° East 42 Lks  
Oak 16" North 11° West 62 Lks

1895: Ed Strong, County Surveyor; Placed buggy stub at 20.00 Chains from East 1/4 Post.

1959: R. Gove, Surveyor; Set 3/8" rod at intersection of 1/4 Lines.

**B. Description of corner evidence found and/or method applied in restoring or reestablishing corner:**

1971: J. Kester, Surveyor RLS#16046; Used iron set by Gove in survey recorded Liber 1, Page 6, Kalamazoo County Recorded Surveys.

1995: Found iron 1.18' South and 0.15' West of intersection of 1/4 Lines. Used iron for Section breakdown of Northeast 1/4 Section 20.

**RATIFIED  
BY KALAMAZOO COUNTY  
REMONUMENTATION  
PEER GROUP**  
6-15-95 *R.S.P.*

**C. Description of monument for corner and accessories established to perpetuate locating the position of the corner:**

D-8 Center of Section, Section 20, T. 1 S., R. 11 W., Ratified by the Kalamazoo County Remonumentation Program Peer Group on June 15, 1995 and is accepted as the best available evidence of the position of the corner. This position not established by original government surveyors. Found 3/8" iron as set in survey by Robert Gove in 1959. Removed iron and set a 30" Harrison monument.

PK Nail in West Side 28" Oak North 04° East 51.02' North & South Fence West 0.8'  
PK Nail in North Side 28" Ash North 30° West 23.69'  
PK Nail in South Side 24" Maple South 74° East 44.70'  
PK Nail in South Side 15" Oak South 24° East 28.44'  
East and West Fence South 0.4'

Signed by *Garth N. Baden*

Date Aug 23, 1995

Surveyor's Michigan License No. 10679