

APR 01 1996

COMMISSION

LAND CORNER RECORDATION CERTIFICATE
Filing Requirement of Act 74, Mich. P.A. 1970

STATE OF MICHIGAN
COUNTY OF KALAMAZOO
RECEIVED FOR RECORD

'95 DEC 8 AM 10 55

For corners in Kalamazoo Located In: Corner Code #
(County)

Cooper

1. Public Land Survey T 1S R 11W D13
T _____ R _____
T _____ R _____
T _____ R _____

2. Property Controlling S _____ T _____ R _____
in Section S _____ T _____ R _____

3. Miscellaneous S _____ T _____ R _____
Property in Section S _____ T _____ R _____

4. Lot No. _____, Recorded Plat _____

5. Private Claims _____

James D. Young
CLERK-REGISTER

LIBER 1 1391

Register of Deeds Stamp & File Number

I, Gary D. Hahn, in a field survey on April 28, 1995, do hereby certify that under requirements of P.A. 74, Michigan P.A. of 1970, the corner points mentioned in lines 1 and 2 above were in conformance with regulations and rules therefore as required in the current manual of survey instructions of the United States Department of the Interior, Bureau of Land Management or by a decree of a Court of Law and/or that the corner points mentioned in lines 3, 4 and 5 above were in conformance with the rules of the Michigan Board of Professional Surveyors or by a Decree of a Court of Law; established, re-established, monumented, re-monumented, recovered, found as expressed below:

A	B	C	D	E	F	G	H	I	J	K	L	M
2	6	5	4	3	2	1						
3												
4	7	8	9	10	11	12						
5												
6	18	17	16	15	14	13						
7												
8	19	20	21	22	23	24						
9												
10	30	29	28	27	26	25						
11												
12	31	32	33	34	35	36						
13												

NOTE: Not more than 4 corners, all in the same town and range, may be recorded on this certificate.

A. Description of original monument and accessories and/or subsequent restoration:

1827 Quarter post established by U.S. Deputy Surveyor John Mullett.
Accessories: Beech 9in N66E 31 lks. Beech 8in N78W 221ks.

1900 E. Strong "Found brick E 88½ Set iron bolt"

1994 L.C.R.C. Liber 1, Page 1130 Thomas Chettleburgh RLS-16036
"Sauers 1974, iron bar in monument box "Lands-End No. 1" Subdivision.
Iron bar in monument box.

Accessories: South side 4" steel fence post North 26.29'
2" bar in monument box East 58.24' Spike SE side 15" Maple N53°E 37.58'

B. Description of corner evidence found and/or method applied in restoring or reestablishing corner:

Original monument and accessories not recovered.


Found 5/8" rod 1' long with threads on bottom end. Assumed to be Strong's bolt. (Rod was found in mon. box) Rod was 4" below asphalt road. Removed bolt and got no other "draw" beneath bolt. Road appears to have been cut 2' +/- below surrounding ground.

RATIFIED
BY KALAMAZOO COUNTY
REMONUMENTATION
PEER GROUP
6-15-95

R.E.S.

C. Description of monument for corner and accessories established to perpetuate locating the position of the corner:
D13, South Quarter corner Section 32, T1S, R11W, Ratified by Kalamazoo County Remonumentation Peer Group on June 15, 1995. 5/8" rod is accepted as a Careful and faithful perpetuation of the position of the original corner. Removed rod and placed a 20" Harrison monument in a monument box.

Set P.K. nail in 6" Maple N1°W 27.97'
Fnd. cabin spike in 16" Maple N55°E 37.57'
Set P.K. nail in 16" Twin Hickory S32°W 33.54'
Set P.K. nail in N. Face 6" Maple S48°E 44.07'
Fnd. 2 1/8" square topped rod in mon. box East 58.24'

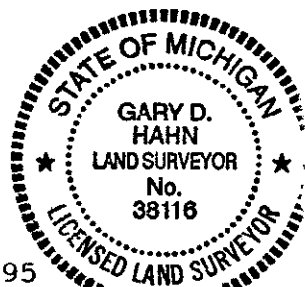

Signed by *Gary D. Hahn*
Surveyor's Michigan License No. 38116

Date December 5, 1995