

**SURVEY &
REMONUMENTATION**

STATE OF MICHIGAN
COUNTY OF KALAMAZOO
RECEIVED FOR RECORD

APR 27 1995

**LAND CORNER RECORDATION CERTIFICATE
COMMISSION**

Filing Requirement of Act 74, Mich. P.A. 1970

85 JAN 5 AM 9 46

For corners in

Kalamazoo

(County)

Cooper Township

1. Public Land Survey

Located In:

Corner Code #

T 1 S R 11 W

E-3

T R

T R

T R

T R

2. Property Controlling
in Section

S T R

S T R

3. Miscellaneous

S T R

Property in Sec.

S T R

4. Lot No. , Recorded Plat

5. Private Claims

James J. Jones

CLERK-REGISTER

LIBER


1 PG 1253

Register of Deeds Stamp & File Number

I, Robert E. Snell, in a field survey on May 3, 19 94,

do hereby certify that under requirements of P.A. 74, Michigan P.A. of 1970, the corner points mentioned in lines 1 and 2 above were in conformance with regulations and rules therefore as required in the current manual of survey instructions of the United States Department of the Interior, Bureau of Land Management or by a decree of a Court of Law and/or that the corner points mentioned in lines 3, 4 and 5 above were in conformance with the rules of the Michigan Board of Land Surveyors or by a Decree of a Court of Law; established, re-established, monumented, re-monumented, recovered, found as expressed below:

NOTE: Not more than 4 corners, all in the same town and range, may be recorded on this certificate.

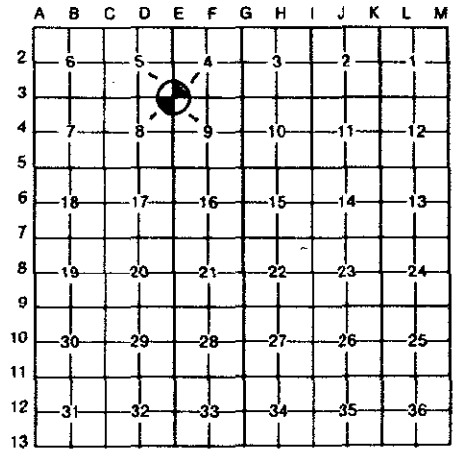

A. Description of original monument and accessories and/or subsequent restoration:

1826: U.S. Government Survey; Set Post, Corner to Sections 4, 5, 8 and 9.

Beech 24" North 13° East 21 Lks
Sasafras 7" South 30° West 19 Lks

1870: F. Hodgman, County Surveyor; Section Corner lost and restored at proportional distances from nearest Corners North, South, East, and West. Planted 2 stones and brick with stake beneath.

W. Ash 10" North 24½° West 97 Lks
Maple 10" North 38½° East 68 Lks

1944: Wilkins and Wheaton Engineering Company; Found 2 stones and brick. Placed iron.

B. Description of corner evidence found and/or method applied in restoring or reestablishing corner:

1971: D. Ratekin, Surveyor; LCRC, Liber 1, Page 5, carriage bolt.

1994: Found carriage bolt over iron and 2 stones and brick below.

**RATIFIED
BY KALAMAZOO COUNTY
REMONUMENTATION
PEER GROUP
7-21-94**

R.E.S.

C. Description of monument for corner and accessories established to perpetuate locating the position of the corner:

E-3 Southeast Corner Section 5, T. 1 S., R. 11 W., Ratified by the Kalamazoo County Remonumentation Program Peer Group on July 21, 1994. Found iron over 2 stones and brick. The 2 stones and brick were placed in 1870 survey by F. Hodgman and is accepted as a careful and faithful perpetuation of the position of the original corner. Removed iron and placed a 20" Harrison monument with a monument box over stones and brick.

Nail in Telephone Pole North 40° East 56.39'
PK Nail in North Root 38" Maple North 60° East 69.94'
PK Nail in Southwest Side 14' Maple North 26° West 68.11'
Nail/Tab in Telephone Pole South 26° West 51.97'

Signed by

Robert E. Snell

Date

1-3-1995

Surveyor's Michigan License No.

9734