

FEB 08 2000

SECTION

**LAND CORNER RECORDATION CERTIFICATE**  
 Filing Requirement of Act 74, Mich. P.A. 1970

For corners in

Kalamazoo  
 (County)  
 Cooper Township  
 1. Public Land Survey

Located In: T 1 S R 11 W  
 Corner Code #: E-7

T \_\_\_ R \_\_\_  
 T \_\_\_ R \_\_\_  
 T \_\_\_ R \_\_\_  
 S \_\_\_ T \_\_\_ R \_\_\_  
 S \_\_\_ T \_\_\_ R \_\_\_  
 S \_\_\_ T \_\_\_ R \_\_\_  
 S \_\_\_ T \_\_\_ R \_\_\_


LC-000005  
 Page: 1 of 1  
 07/12/1999 10:05A  
 Bk-2 Pg-458  
 CRANE LAND SURVEYING LANDCOR-Kalamazoo

Register of Deeds Stamp & File Number

4. Lot No. \_\_\_\_\_, Recorded Plat \_\_\_\_\_  
 5. Private Claims \_\_\_\_\_

I, William K. Crane, in a field survey on September 25, 1997 do hereby state that under requirements of P.A. 74, Michigan P.A. of 1970, the corner points mentioned in lines 1 and 2 above were in conformance with regulations and rules therefore as required in the current manual of survey instructions of the United States Department of the Interior, Bureau of Land Management or by a decree of a Court of Law and for that the corner points mentioned in lines 3, 4 and 5 above were in conformance with the rules of the Michigan Board of Land Surveyors or by a Decree of a Court of Law; established, re-established, monumented, recovered, found as expressed below:

**NOTE:** Not more than 2 corners, all in the same town and range, may be recorded on this certificate.

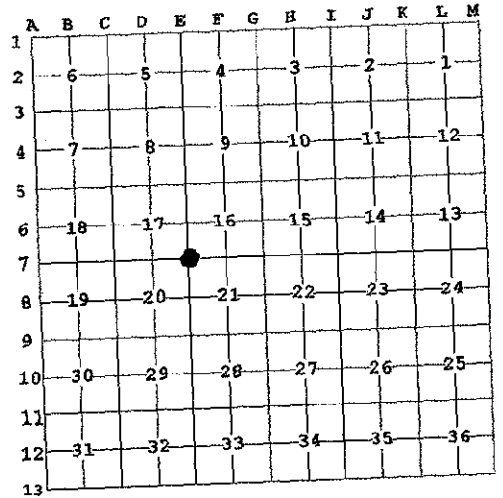

A. Description of original monument and accessories and/or subsequent restoration:

G.L.O., John Mullett, D.S., 1827:  
 9" W. Oak S 38° W 25 links  
 8" W. Oak N 62° E 31 links

F. Stimson, 1864:  
 Planted stone

F. Hodgman, 1875:  
 Found stone of former survey good

E. Strong, 1895:  
 Did not find, but took SE corner post as correct

Kalamazoo County Road Commission, 1920s:  
 SE corner store NW 52.6'  
 P. pole SE 41.9'  
 18" Maple S 45° W 35.1'  
 NW corner of house SE 116.8'

LCRC, Middleton, 1975:  
 Found boat spike in monument box  
 P. pole S 50° W 51.45'  
 P. pole S 25° E 56.05'  
 24" Maple S 70° E 66.58'  
 T. pole N 40° E 56.40'

B. Description of corner evidence found and/or method applied in restoring or reestablishing corner:


Found boat spike in monument box, dug 3 feet and found nothing else. Previous ties check. Replaced boat spike with Harrison monument and reset monument box.

C. Description of monument for corner and accessories established to perpetuate locating the position of the corner:

Boat spike is accepted as the best available evidence of the position of the original corner. Replaced boat spike with Harrison monument and reset monument box.

Utility pole S 50° W 51.45'  
 Utility pole S 25° E 56.05'  
 Utility Pole S 50° E 61.51'  
 Utility pole N 40° E 56.40'

**RATIFIED**  
**BY KALAMAZOO COUNTY**  
**REMONUMENTATION**  
**PEER GROUP**  
 5-4-1999

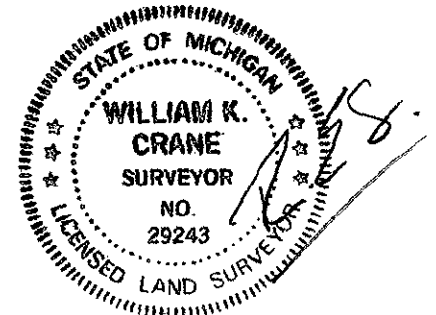

Signed by William K. Crane Date July 12, 1999  
 William K. Crane, P.S.  
 Surveyor's Michigan License No. 29243