

SURVEY & REMONUMENTATION

SEP 17 1999

STATE OF MICHIGAN
COUNTY OF KALAMAZOO
RECEIVED FOR RECORD
'96 AUG 15 AM 8 48


6428 SECTION
For corners in
KALAMAZOO
(County)

LAND CORNER RECORDATION CERTIFICATE
Filing Requirement of Act 74, Mich. P.A. 1970

	Located In:	Corner Code #
1. Public Land Survey	T <u>1S</u> R <u>11W</u>	<u>E13</u>
	T _____ R _____	_____
	T _____ R _____	_____
	T _____ R _____	_____
2. Property Controlling in Section	S _____ T _____ R _____	_____
	S _____ T _____ R _____	_____
3. Miscellaneous Property in Section	S _____ T _____ R _____	_____
	S _____ T _____ R _____	_____

James J. Young
CLERK-REGISTER
LIBER 2PAGE 042
Register of Deeds Stamp & File Number

4. Lot No. _____, Recorded Plat _____
5. Private Claims _____

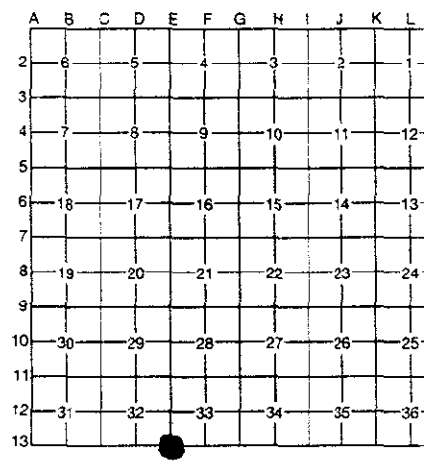

I, GARY D. HAHN, in a field survey on APRIL 29, 19 95, do hereby certify that under requirements of P.A. 74, Michigan P.A. of 1970, the corner points mentioned in lines 1 and 2 above were in conformance with regulations and rules therefore as required in the current manual of survey instructions of the United States Department of the Interior, Bureau of Land Management or by a decree of a Court of Law and/or that the corner points mentioned in lines 3, 4 and 5 above were in conformance with the rules of the Michigan Board of Professional Surveyors or by a Decree of a Court of Law; established, re-established, monumented, re-monumented, recovered, found as expressed below:

NOTE: Not more than 4 corners, all in the same town and range, may be recorded on this certificate.

A. Description of original monument and accessories and/or subsequent restoration:

1827 Corner post established by U.S. Deputy Surveyor John Mullett
Accessories: Beech 12 in N16°E 311ks.
Beech 12 in N56°W 68 lks.

B. Description of corner evidence found and/or method applied in restoring or reestablishing corner:

Original monument and accessories not recovered.

Found 3/4" dia. 16" long rod in mon. box.


Dug down 4' through dirt and gravel to light sand. Did not find anything. Road is 2' - 3' below natural ground on either side.

RATIFIED
BY KALAMAZOO COUNTY
REMONUMENTATION
PEER GROUP
6-15-1995

C. Description of monument for corner and accessories established to perpetuate locating the position of the corner:

E13, Southeast corner Section 32, T1S, R11W, Ratified by Kalamazoo County Remonumentation Peer Group on June 15, 1995. Location of 3/4" rod is accepted the best available evidence of the position of the original corner. Removed rod and replaced with a 30" Harrison Monument in mon. box.

- Top bolt on hydrant N1°W 24.89'
- Set P.K. nail in W. side of 33" Maple S42°E 35.44'
- Set P.K. nail in 16" Maple N46°W 50.45'
- Set P.K. nail in 18" Maple S50°W 45.37'
- Fnd. State of Michigan Monument East 43.50'

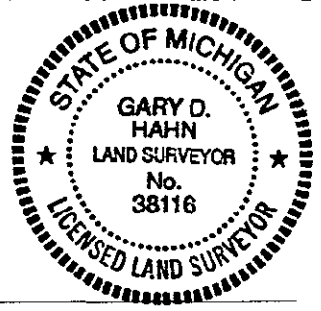

Signed by *Gary D. Hahn* Date 8-31-95
Surveyor's Michigan License No. 38116