

LAND CORNER RECORDATION CERTIFICATE
Filing Requirement of Act 74, Mich. P.A. 1970

LIBER 2 PAGE 337
STATE OF MICHIGAN
COUNTY OF KALAMAZOO
RECEIVED FOR RECORD


'88 OCT 20 AM 11 25

Timothy Johnson

CLERK - REGISTER

Register of Deeds Stamp & File Number

<u>KALAMAZOO</u> (County)	Located In:	Corner Code #
1. Public Land Survey	T 1S R 11W	F-3
	T R	
	T R	
	T R	
2. Property Controlling in Section	S T R	
	S T R	
3. Miscellaneous Property in Sec.	S T R	
	S T R	
4. Lot No. _____, Recorded Plat		
5. Private Claims		

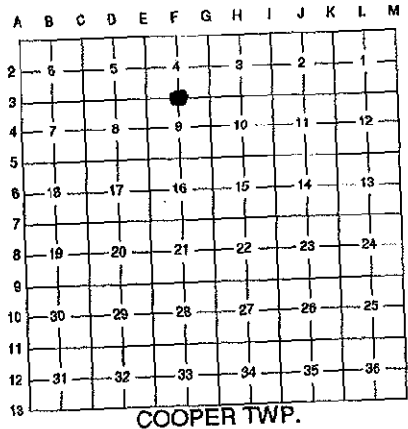

I, WILLIAM K. CRANE, P.S., in a field survey on MAY 14, 19 97 do hereby state that under requirements of P.A. 74, Michigan P.A. of 1970, the corner points mentioned in lines 1 and 2 above were in conformance with regulations and rules therefore as required in the current manual of survey instructions of the United States Department of the Interior, Bureau of Land Management or by a decree of a Court of Law and /or that the corner points mentioned in lines 3, 4 and 5 above were in conformance with the rules of the Michigan Board of Land Surveyors or by a Decree of a Court of Law; established, re-established, monumented, recovered, found as expressed below:

NOTE: Not more than 2 corners, all in the same town and range, may be recorded on this certificate.

A. Description of original monument and accessories and/or subsequent restoration:

G.L.O.:
6" IRONWOOD, N83°E, 11 LINKS
7" BEECH, WEST 24 LINKS

B. Description of corner evidence found and/or method applied in restoring or reestablishing corner:

FOUND CAPPED IRON NO 26463 IN MONUMENT BOX. EXCAVATED APPROXIMATELY 2' AND FOUND A 3/4" IRON ROD. FURTHER EXCAVATION REVEALED NOTHING ELSE. REPLACED WITH HARRISON MARKER AND MONUMENT BOX.

**SURVEY &
REMONUMENTATION**

NOV 25 1998


SECTION

RATIFIED
BY KALAMAZOO COUNTY
REMONUMENTATION
PEER GROUP
7-16-1998

C. Description of monument for corner and accessories established to perpetuate locating the position of the corner:

FOUND 3/4" IRON IS ACCEPTED AS THE BEST AVAILABLE EVIDENCE OF THE POSITION OF THE ORIGINAL CORNER. REPLACED IRON WITH HARRISON MARKER AND MONUMENT BOX.

FOUND NAIL & SPOTTER IN E. SIDE OF 16" ELM, N.20°W, 58.21'
FOUND NAIL & SPOTTER IN S. SIDE OF 30" ELM, N.56°E, 41.53'
FOUND NAIL & SPOTTER IN S.W. SIDE OF 14" ELM, S.40°E, 42.45'
FOUND NAIL & SPOTTER IN S.E. SIDE OF 20" MAPLE, S.74°W, 82.66'
2.5' WEST OF CENTERLINE OF NORTH/SOUTH ROAD
1.5' SOUTH OF CENTERLINE OF EAST/WEST ROAD

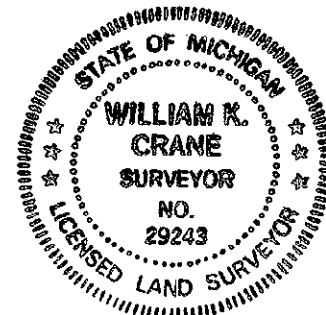

Signed by *William K. Crane*

Date 10/19/98

William K. Crane, P.S.

Surveyor's Michigan License No.: 29243

FORM APPROVED BY MICHIGAN STATE BOARD OF PROFESSIONAL SURVEYORS, JAN. 28, 1971

REVISED MAY 14, 1975
REVISED JAN., 1983
REVISED OCT., 1995