

APR 01 1996

COMMISSION LAND CORNER RECORDATION CERTIFICATE

Filing Requirement of Act 74, Mich. P.A. 1970

STATE OF MICHIGAN  
COUNTY OF KALAMAZOO  
RECEIVED FOR RECORD

'95 DEC 8 AM 10 55

For corners in  
Kalamazoo  
(County)

Located In:

Corner Code #

Cooper Twp.

1. Public Land Survey	T	<u>1S</u>	R	<u>11W</u>	<u>K2</u>
	T	_____	R	_____	_____
	T	_____	R	_____	_____
	T	_____	R	_____	_____
2. Property Controlling in Section	S	_____	T	_____	R
	S	_____	T	_____	R
3. Miscellaneous Property in Section	S	_____	T	_____	R
	S	_____	T	_____	R

*James D. Young*  
CLERK-REGISTER

LIBER 1 1389

Register of Deeds Stamp & File Number

- 4. Lot No. \_\_\_\_\_, Recorded Plat \_\_\_\_\_
- 5. Private Claims \_\_\_\_\_

A	B	C	D	E	F	G	H	I	J	K	L	M
2	6	5	4	3	2	1						
3												
4	7	8	9	10	11	12						
5												
6	18	17	16	15	14	13						
7												
8	19	20	21	22	23	24						
9												
10	30	29	28	27	26	25						
11												
12	31	32	33	34	35	36						
13												

I, Gary D. Hahn, in a field survey on May 4, 19 95, do hereby certify that under requirements of P.A. 74, Michigan P.A. of 1970, the corner points mentioned in lines 1 and 2 above were in conformance with regulations and rules therefore as required in the current manual of survey instructions of the United States Department of the Interior, Bureau of Land Management or by a decree of a Court of Law and/or that the corner points mentioned in lines 3, 4 and 5 above were in conformance with the rules of the Michigan Board of Professional Surveyors or by a Decree of a Court of Law; established, re-established, monumented, re-monumented, recovered, found as expressed below:

NOTE: Not more than 4 corners, all in the same town and range, may be recorded on this certificate.

A. Description of original monument and accessories and/or subsequent restoration:

- 1827 Quarter post established by U.S. Deputy Surveyor John Mullett  
Accessories: W. Oak 10in S49°E 371k. W. Oak 30in N75°W 511k.
- 1869 E. Strong "E $\frac{1}{4}$  - Stone one US stand."
- 1961 Ingersol Watson McMachen - Found stone - Set iron over.
- 1980 D.A. Ratekin & Assoc., Inc. - John H. Dillingham - Unrecorded survey.  
1/2" Iron Accessories: Centerline of road West 1'+/-  
Found nail & tag in SW side 30" Maple N45°W 37.41'  
Face of 24" Walnut S70°W 24.3'  
P.K. nail in W side Twin 24" W. Cherries N20°E 40.97'  
P.K. nail in NE side 30" Oak S45°E 31.74'

B. Description of corner evidence found and/or method applied in restoring or reestablishing corner:

Original monument and accessories not recovered.


Found P.K. nail in asphalt road. Removed P.K. nail and asphalt and found a 1/2" rebar directly under P.K. nail. Dug a 3.5' x 5' x 7' deep hole. Found no further evidence of corner location.

RATIFIED  
BY KALAMAZOO COUNTY  
REMONUMENTATION  
PEER GROUP  
9-21-95

*R.25*

C. Description of monument for corner and accessories established to perpetuate locating the position of the corner:

- K2, T1S, R11W, Cooper Twp., Ratified by Kalamazoo County Remonumentation Peer Group on September 21, 1995. The position of the 1/2" rebar is accepted as the best available evidence of the position of the corner. Removed rebar and replaced with a 30" Harrison monument in a monument box.
- Fnd. 1/2" capped rebar (J.H.D. 16927) East 33.00'
- Fnd. nail with tab in 40" Oak N45°W 37.40'
- Fnd. P.K. nail above nail with tab in 37" stump S55°E 31.70'
- Set P.K. nail in 10" Oak East 41.59'
- Set P.K. nail in 34" Oak S70°W 25.02'

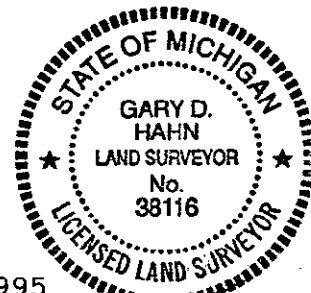

Signed by *Gary D. Hahn*

Date December 5, 1995

Surveyor's Michigan License No. 38116