

APR 01 1996

COMMISSION

STATE OF MICHIGAN  
COUNTY OF KALAMAZOO  
RECEIVED FOR RECORD

'95 DEC 8 AM 10 55

**LAND CORNER RECORDATION CERTIFICATE**  
Filing Requirement of Act 74, Mich. P.A. 1970

For corners in KALAMAZOO Located In: \_\_\_\_\_ Corner Code # \_\_\_\_\_  
(County)

COOPER TWP.


1. Public Land Survey	T <u>1</u> S R <u>11</u> W	<u>K3</u>
	T _____ R _____	_____
	T _____ R _____	_____
	T _____ R _____	_____
2. Property Controlling in Section	S _____ T _____ R _____	_____
	S _____ T _____ R _____	_____
3. Miscellaneous Property in Section	S _____ T _____ R _____	_____
	S _____ T _____ R _____	_____

*James Young*  
CLERK-REGISTER

LIBER **1 1393**

Register of Deeds Stamp & File Number

- 4. Lot No. \_\_\_\_\_, Recorded Plat \_\_\_\_\_
- 5. Private Claims \_\_\_\_\_

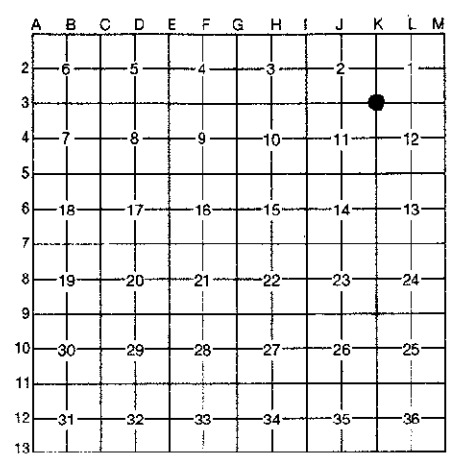

I, GARY D. HAHN, in a field survey on MAY 3, 1995, do hereby certify that under requirements of P.A. 74, Michigan P.A. of 1970, the corner points mentioned in lines 1 and 2 above were in conformance with regulations and rules therefore as required in the current manual of survey instructions of the United States Department of the Interior, Bureau of Land Management or by a decree of a Court of Law and/or that the corner points mentioned in lines 3, 4 and 5 above were in conformance with the rules of the Michigan Board of Professional Surveyors or by a Decree of a Court of Law; established, re-established, monumented, re-monumented, recovered, found as expressed below:

**NOTE: Not more than 4 corners, all in the same town and range, may be recorded on this certificate.**

**A. Description of original monument and accessories and/or subsequent restoration:**

1827 Corner post established by U.S. Deputy Surveyor John Mullett  
Accessories: W. Oak 8in S6°W 28 lk. W. Oak 12in N5°W 26 lk.

1869 E. Strong SE. Cor. stone 26x12x12 set from one US in place of stone by stinson.

Date? KCRC notes: 16" Oak N60°E 58.8' 16" Oak S45°E 44.0' 24" Oak S24°W 42.4'  
iron (Gove) 18' Oak S50°E 44.3' 16" Oak N60°E 58.6'  
24" Oak S45°W 42.1'

**B. Description of corner evidence found and/or method applied in restoring or reestablishing corner:**

Original monument and accessories not recovered.

Found P.K. nail in asphalt road 4' south of centerline road.

Found 12" x 12" x 24" stone on its side 3.5' deep to the west of the nail. Standing stone up (point up) puts the stone within 1' of the P.K. nail location.

**RATIFIED**  
**BY KALAMAZOO COUNTY**  
**REMONUMENTATION**  
**PEER GROUP**  
6-15-95 *[Signature]*

**C. Description of monument for corner and accessories established to perpetuate locating the position of the corner:**

K3, Southeast corner Section 2, T1S, R11W, Ratified by Kalamazoo County Remonumentation Peer Group on June 15, 1995. The position of the P.K. nail is accepted as the best available evidence of the position of the original corner. Removed P.K. nail and replaced with a 20" Harrison Monument in mon. box approximately 1' East of the stone.

- End. P.K. nail in 29" Oak N62°E 58.46'
- End. P.K. nail in 25" Oak S68°E 77.43'
- End. capped 1/2" rebar (RLS 16049 & 13583) South 33.03'
- End. P.K. nail in 32" Oak S55°W 42.04'
- End. P.K. nail in 9" Twin Oak N48°W 79.70'

Signed by *[Signature: Gary D. Hahn]*

Date 9-1-95

Surveyor's Michigan License No. 38116

