

**SURVEY &
REMONUMENTATION**

APR 27 1995

STATE OF MICHIGAN
COUNTY OF KALAMAZOO
RECEIVED FOR RECORD

COMMISSION LAND CORNER RECORDATION CERTIFICATE

Filing Requirement of Act 74, Mich. P.A. 1970 94 DEC 15 PM 1 36

For corners in COOPER TWP.

<u>KALAMAZOO</u> <small>(County)</small>	Located In:	Corner Code #
1. Public Land Survey	T <u>1</u> S R <u>11</u> W	<u>K-8</u>
	T _____ R _____	_____
	T _____ R _____	_____
	T _____ R _____	_____
2. Property Controlling in Section	S _____ T _____ R _____	_____
	S _____ T _____ R _____	_____
3. Miscellaneous Property in Sec.	S _____ T _____ R _____	_____

James J. J...
CLERK-REGISTER

LIBER 1 PG 1222

Register of Deeds Stamp & File Number

4. Lot No. _____, Recorded Plat _____
5. Private Claims _____

A	B	C	D	E	F	G	H	I	J	K	L	M
2	6	5	4	3	2	1						
3												
4	7	8	9	10	11	12						
5												
6	18	17	16	15	14	13						
7												
8	19	20	21	22	23	24						
9												
10	30	29	28	27	26	25						
11												
12	31	32	33	34	35	36						
13												

I, Allen H. McMachen a field survey on January 31, 1994, do hereby certify that under requirements of P.A. 74, Michigan P.A. of 1970, the corner points mentioned in lines 1 and 2 above were in conformance with regulations and rules therefore as required in the current manual of survey instructions of the United States Department of the Interior, Bureau of Land Management or by a decree of a Court of Law and/or that the corner points mentioned in lines 3, 4 and 5 above were in conformance with the rules of the Michigan Board of Land Surveyors or by a Decree of a Court of Law; established, re-established, monumented, re-monumented, recovered, found as expressed below:

NOTE: Not more than 4 corners, all in the same town and range, may be recorded on this certificate.

A. Description of original monument and accessories and/or subsequent restoration:

- 1827 - Government set original corner.
- 1865 - Stake reset from witness trees.
- 1883 - Found old Stake good, set Iron lid, glass and stake.

Accessories:

- Oak 24" S. 47° W. 76 lks.
- Oak 20" S. 81° E. 48 lks.

No Date - Found large Stone 1' South of fence to East.


Accessories:

- Y.O. 40" S. 85° E. 31.0' Y.O. 60" S. 45° W. 48.8'
- Elm 12" N. 60° W. 24.8'

B. Description of corner evidence found and/or method applied in restoring or reestablishing corner:

Found large Stone with "X" on top 1.3' below pavement surface in monument box.

RATIFIED
BY KALAMAZOO COUNTY
REMONUMENTATION
PEER GROUP
3-17-94 *R.E.S.*

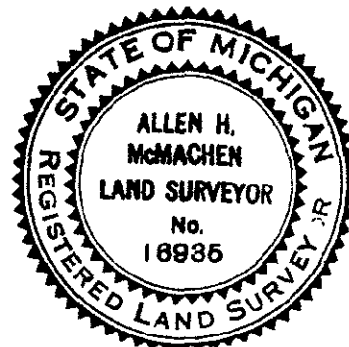

C. Description of monument for corner and accessories established to perpetuate locating the position of the corner:

Found Stone is accepted as a careful and faithful perpetuation of the original corner. Removed Stone and monument box. Place harrison monument and monument box over.

Accessories:

- "PK" Nail & Tab in N. side Utility Pole EAST 58.52'
- "PK" Nail & Tab in E. side Utility Pole N. 43° W. 41.02'
- Nail & Tab in W. side 18" Oak S. 25° E. 62.13'
- Nail & Tab in N. side 8" Elm S. 88° W. 36.95'

Signed by *Allen H. McMachen* Date 12/15/94
Surveyor's Michigan License No. 16935