

APR 01 1996

STATE OF MICHIGAN  
COUNTY OF KALAMAZOO  
RECEIVED FOR RECORD  
'95 DEC 8 AM 10 55

COMMISSION LAND CORNER RECORDATION CERTIFICATE  
Filing Requirement of Act 74, Mich. P.A. 1970

For corners in Kalamazoo (County) Located In: \_\_\_\_\_ Corner Code # \_\_\_\_\_

Cooper Twp.


1. Public Land Survey	T	<u>1S</u>	R	<u>11W</u>	<u>L5</u>
	T	_____	R	_____	_____
	T	_____	R	_____	_____
	T	_____	R	_____	_____
2. Property Controlling in Section	S	_____	T	_____	_____
	S	_____	T	_____	_____
3. Miscellaneous Property in Section	S	_____	T	_____	_____
	S	_____	T	_____	_____

*James Young*  
CLOCK-REGISTER

LIBER 1 1394

Register of Deeds Stamp & File Number

4. Lot No. \_\_\_\_\_, Recorded Plat \_\_\_\_\_  
5. Private Claims \_\_\_\_\_

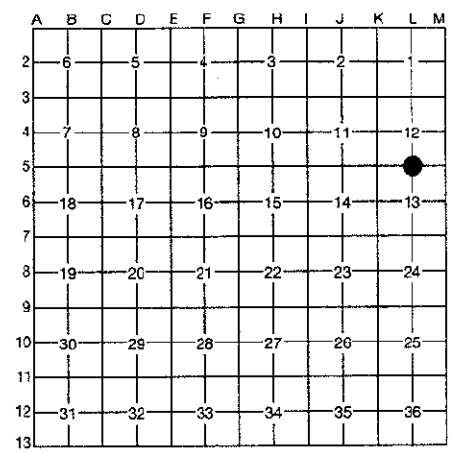

I, Gary D. Hahn, in a field survey on April 28, 19 95, do hereby certify that under requirements of P.A. 74, Michigan P.A. of 1970, the corner points mentioned in lines 1 and 2 above were in conformance with regulations and rules therefore as required in the current manual of survey instructions of the United States Department of the Interior, Bureau of Land Management or by a decree of a Court of Law and/or that the corner points mentioned in lines 3, 4 and 5 above were in conformance with the rules of the Michigan Board of Professional Surveyors or by a Decree of a Court of Law; established, re-established, monumented, re-monumented, recovered, found as expressed below:

**NOTE: Not more than 4 corners, all in the same town and range, may be recorded on this certificate.**

A. Description of original monument and accessories and/or subsequent restoration:

1827 Quarter post established by U.S. Deputy Surveyor John Mullett.  
W. oak 36 in. N32°W 37 lks. Y. Oak 20 in. S61°E 11 lks.

1875 E. Strong Co. Sur. "S1/4 - stone from 1 stump by Stimson."

Date? KCRC notes: (H) Y.O. 18" S24½°W 77 1/3 51.04'  
(H) W.O. 36" S61½°E 137 90.42'



B. Description of corner evidence found and/or method applied in restoring or reestablishing corner:

Original monument and accessories not recovered.

Found stone in monument box 8' north of centerline of road.

Stone is 8" x 8" x 1.2' with point up and divot in middle. Stone was 0.7' below surface of road. Also found small stones around pointed stone.

**RATIFIED  
BY KALAMAZOO COUNTY  
REMONUMENTATION  
PEER GROUP  
6-15-95**

C. Description of monument for corner and accessories established to perpetuate locating the position of the corner:

L5, South quarter corner Section 12, T1S, R11W, Ratified by Kalamazoo County Remonumentation Peer Group on June 15, 1995. Location of pointed stone is accepted as a careful and faithful perpetuation of the position of the original corner. Removed stone and replaced with a 20" Harrison monument in a monument box.

Found 1/2" rebar w/cap (RLS 22446) South 33.10'  
Found P.K. nail in 29" Twin Oak S8°W 32.45'  
Found P.K. nail in wood fence post North 25.45'  
Set P.K. nail in wood fence post N52°W 42.27'

Signed by *Gary D. Hahn*

Date September 23, 1995

Surveyor's Michigan License No. 38116