

**SURVEY &  
REMONUMENTATION**

**OCT 06 1997**

**COMMISSION**

LIBER 2 PAGE 170

**LAND CORNER RECORDATION CERTIFICATE  
Filing Requirement of Act 74, Mich. P.A. 1970**

For corners in Cooper Twp.  
Kalamazoo  
(County)

Located In: Corner Code #

1. Public Land Survey	T	<u>1S.</u>	R	<u>11W.</u>	<u>M-8</u>
	T	_____	R	_____	_____
	T	_____	R	_____	_____
	T	_____	R	_____	_____
2. Property Controlling in Section	S	_____	T	_____	_____
	S	_____	T	_____	_____
3. Miscellaneous Property in Section	S	_____	T	_____	_____
	S	_____	T	_____	_____

STATE OF MICHIGAN  
COUNTY OF KALAMAZOO  
RECEIVED FOR RECORD  
'97 JUL 29 PM 3 57  
*Janice Brown*  
CLERK - REGISTER

Register of Deeds Stamp & File Number

4. Lot No. \_\_\_\_\_, Recorded Plat \_\_\_\_\_  
5. Private Claims \_\_\_\_\_

A	B	C	D	E	F	G	H	I	J	K	L	M
2	6	5	4	3	2	1						
3												
4	7	8	9	10	11	12						
5												
6	18	17	16	15	14	13						
7												
8	19	20	21	22	23	24						
9												
10	30	29	28	27	26	25						
11												
12	31	32	33	34	35	36						
13												

I, Allen H. McMachen, in a field survey on June 2, 1997, do hereby certify that under requirements of P.A. 74, Michigan P.A. of 1970, the corner points mentioned in lines 1 and 2 above were in conformance with regulations and rules therefore as required in the current manual of survey instructions of the United States Department of the Interior, Bureau of Land Management or by a decree of a Court of Law and/or that the corner points mentioned in lines 3, 4 and 5 above were in conformance with the rules of the Michigan Board of Professional Surveyors or by a Decree of a Court of Law; established, re-established, monumented, re-monumented, recovered, found as expressed below:

**NOTE: Not more than 4 corners, all in the same town and range, may be recorded on this certificate.**

**A. Description of original monument and accessories and/or subsequent restoration:**

1827 - John Mullett, D.S.  
Set quarter Section post,  
Aspen 12" N. 35° W. 31 lks.  
D.O. 14" S. 31° W. 3 lks.

1865 - M.M. Stimson, Dept. Co. Surveyor, "Could not find quarter corner East side Section."  
1973 - Ingersoll, Watson & McMachen, Inc., Found stone with "X".

**B. Description of corner evidence found and/or method applied in restoring or reestablishing corner:**  
Intersected witnesses from 1973 Survey to establish old location of West quarter corner, Section 19, Richland Township, measured South 41 feet and found stone with "X" at East quarter corner, Section 24. Found stone was pointed and meas. ±24" high by ±16" dia. at base. Replaced stone with standard marker.


**RATIFIED  
BY KALAMAZOO COUNTY  
REMONUMENTATION  
PEER GROUP  
6-19-1997**

*R.E.S.*

**C. Description of monument for corner and accessories established to perpetuate locating the position of the corner:**

Found pointed stone is accepted a careful and faithful perpetuation of the position of the original corner. Replaced found stone with a Standard Harrison Monument, Accessories:

- Nail in Southerly face 16" Oak N. 70° E. 37.6'
- Nail in Southeasterly face 16" Oak S. 55° W. 43.3'
- Nail in Southerly face 8" Oak West 14.50'
- Nail in Westerly face 14" Twin Oak N. 10° W. 23.35'

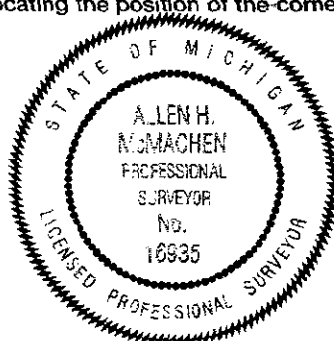

Signed by *Allen H. McMachen*  
Surveyor's Michigan License No. 16935

Date 7/14/97