

APR 01 1996

LAND CORNER RECORDATION CERTIFICATE

Filing Requirement of Act 74, Mich. P.A. 1970

95 DEC 27 AM 10 38

For corners in COMMISSION

Kalamazoo  
(County)  
Alamo Twp.

Located In: N.W. Cor. Sec. 36

Corner Code # A-1 ✓

1. Public Land Survey T 1 S R 12 W  
Common with N.E. Cor.  
Van Buren County T 1 S R 13 W M-1

2. Property Controlling S T R  
in Section S T R

3. Miscellaneous S T R  
Property in Sec. S T R

*James E. Boynton*  
CLERK-REGISTER

LIBER **1 1421**

Register of Deeds Stamp & File Number

- 4. Lot No. \_\_\_\_\_, Recorded Plat \_\_\_\_\_
- 5. Private Claims \_\_\_\_\_

**RATIFIED**  
**BY KALAMAZOO COUNTY'S**  
**REMONUMENTATION**  
**PEER GROUP**  
4-20-95

	A	B	C	D	E	F	G	H	I	J	K	L	M
2	6	5	4	3	2	1							
3													
4	7	8	9	10	11	12							
5													
6	18	17	16	15	14	13							
7													
8	19	20	21	22	23	24							
9													
10	30	29	28	27	26	25							
11													
12	31	32	33	34	35	36							
13													


I, James E. Boynton, in a field survey on October 25, 191994, do hereby certify that under requirements of P.A. 74, Michigan P.A. of 1970, the corner points mentioned in lines 1 and 2 above were in conformance with regulations and rules therefore as required in the current manual of survey instructions of the United States Department of the Interior, Bureau of Land Management or by a decree of a Court of Law and/or that the corner points mentioned in lines 3, 4 and 5 above were in conformance with the rules of the Michigan Board of Land Surveyors or by a Decree of a Court of Law; established, re-established, monumented, re-monumented, recovered, found as expressed below:

**NOTE: Not more than 4 corners, all in the same town and range, may be recorded on this certificate.**

A. Description of original monument and accessories and/or subsequent restoration:  
1827, original corner established by William Brookfield, D.S.  
1910, stone and iron set by W.V. Ackley, C.S.  
1946, T.A. Smith, C.S. found pipe from 1910 witnesses and set pipe over.  
1992, L.C.R.C. by J. Hunt calls for found pipe

B. Description of corner evidence found and/or method applied in restoring or reestablishing corner:  
Found pipes and stone from 1992 witnesses and accepted as best evidence of original corner location.  
Set Van Buren County standard marker as directed by the Peer Group on Oct. 5, 1995.  
Kalamazoo County Peer Group subsequently ratified the corner on ~~Sept 21~~ April 26, 1994

C. Description of monument for corner and accessories established to perpetuate locating the position of the Standard Van Buren County marker  
P.P. N. 65°E, 66.92' to nail  
20" Oak S. 70°E. 43.33' to nail  
20" Pine S. 55°W. 20.70' to nail  
40" Oak South 23.82' to nail  
Corner is 7' South of centerline road.

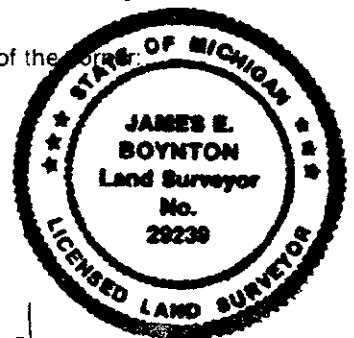

Signed by James E. Boynton Date December 17, 1995  
Surveyor's Michigan License No. 29239