

SURVEY & REMONUMENTATION

FEB 26 1998

LIBER 2PAGE 240

7- SECTION

LAND CORNER RECORDATION CERTIFICATE
Filing Requirement of Act 74, Mich. P.A. 1970

For corners in Alamo Township

STATE OF MICHIGAN
COUNTY OF KALAMAZOO
RECEIVED FOR RECORD
'97 DEC 15 AM 9 59
Clerk - Register

Kalamazoo County (County)	Located in:	Corner Code #
1. Public Land Survey	T1S R12W	A-13
SW Corner, Sec 31	T R	
	T R	
	T R	
2. Property Controlling in Section	S T R	
	S T R	
3. Miscellaneous Property in Sec.	S T R	
	S T R	

Register of Deeds Stamp & File Number

4. Lot No. _____, Recorded Plat _____
5. Private Claims _____

I, Donald R. Gilchrist in a field survey on Dec. 1, 1996 do hereby state that under requirements of P.A. 74, Michigan P.A. of 1970, the corner points mentioned in lines 1 and 2 above were in conformance with regulations and rules therefore as required in the current manual of survey instructions of the United States Department of the Interior, Bureau of Land Management or by a decree of a Court of Law and/or that the corner points mentioned in lines 3, 4 and 5 above were in conformance with the rules of the Michigan Board of Land Surveyors or by a Decree of a Court of Law, established, re-established, monumented, recovered, found as expressed below:

A	B	C	D	E	F	G	H	I	J	K	L	M
1												
2	6		5		4		3		2		1	
3												
4	7		8		9		10		11		12	
5												
6	18		17		16		15		14		13	
7												
8	19		20		21		22		23		24	
9												
10	30		29		28		27		26		25	
11												
12	31		32		33		34		35		36	
13												

NOTE: Not more than 2 corners, all in the same town and range, may be recorded on this certificate.

A. Description of original monument and accessories and/or subsequent restoration:

5/1827 - GOVERNMENT - W. Brookfield, D.S. Ran North on East line of Sec 1, T2S, R13W, a distance of 80.00 chs & set temporary 6-mile post. 12/26/1901 - W. H. Goss, C.S. Book 1, Page 106 - Set piece of 2" gas pipe 4.35' long by old stake. Book 6, Page 100, Red Book (Co. Surveyor Card) - West 39.895 chs. (2633.07') to 1/4 Post (1 1/2" Gas Pipe). 8/1971 - P. I. McPherson, R.L.S. (Consumers Power Co.). Found 2" Pipe 1.5' above grade. Witnesses - 1.5' East of N&S Fence; 15'+- South of centerline of 6' Drain. Drain runs N & W. Measured N 89 Deg 43' 50" E 2633.00' to South 1/4 Post of Section 36 in Pine Grove Township. Approved at the 4/22/94 Van Buren County Peer Group Meeting and is accepted as a careful and faithful perpetuation of the position of the Original Government Corner.

B. Description of corner evidence found and/or method applied in restoring or reestablishing corner:


Fd 2" pipe sticking 1.5' above ground 4.3' long.
1.5' East of down fence cor post.
15'+- S. CL ditch W on CL ditch N.
Set Harrison Marker

Approved at the 4/20/95 Kalamazoo County Peer Group Meeting and is accepted as a careful and faithful perpetuation of the position of the Original Government Corner.

RATIFIED
BY KALAMAZOO COUNTY
REMONUMENTATION
PEER GROUP
4-20-1995

C. Description of monument for corner and accessories established to perpetuate locating the position of the corner:

Harrison Marker.
Set Sur. Marker Post 1's.
Ditch calls are same as above.
16" ash - N 5 Deg W - 23.25' to Pk/N in W. Side.
10" ash - West - 29.36' to Pk/N in S. Side.
20" map - S 15 Deg E - 30.65' to Pk/N in W. Side.
18" ash - S 45 Deg E - 32.98' to Pk/N in SW. Side.

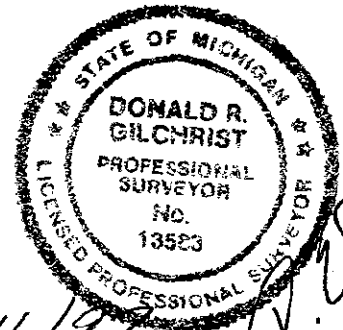

Signed by Donald R. Gilchrist
Surveyor's Michigan License No. RLS #13583

Date 12/11/97