

**SURVEY &
REMONUMENTATION**

FEB 26 1998

1.

2- 405 SECTION

LAND CORNER RECORDATION CERTIFICATE
Filing Requirement of Act 74, Mich. P.A. 1970

LIDER 2PAGE 242

For corners in Alamo Township

<u>Kalamazoo</u> (County)	Located In:	Corner Code #
1. Public Land Survey	T 1S R 12W	D-03
	T R	
	T R	
	T R	
2. Property Controlling in Section	S T R	
	S T R	
3. Miscellaneous Property in Sec.	S T R	
	S T R	

STATE OF MICHIGAN
COUNTY OF KALAMAZOO
RECEIVED FOR RECORD

97 DEC 17 AM 9 30


Clerk - Registrar

Register of Deeds Stamp & File Number

4. Lot No. _____, Recorded Plat _____
5. Private Claims _____

I, Robert E. Snell, in a field survey on Aug. 21, 1997 do hereby state that under requirements of P.A. 74, Michigan P.A. of 1970, the corner points mentioned in lines 1 and 2 above were in conformance with regulations and rules therefore as required in the current manual of survey instructions of the United States Department of the Interior, Bureau of Land Management or by a decree of a Court of Law and/or that the corner points mentioned in lines 3, 4 and 5 above were in conformance with the rules of the Michigan Board of Land Surveyors or by a Decree of a Court of Law, established, re-established, monumented, recovered, found as expressed below.

NOTE: Not more than 2 corners, all in the same town and range, may be recorded on this certificate.

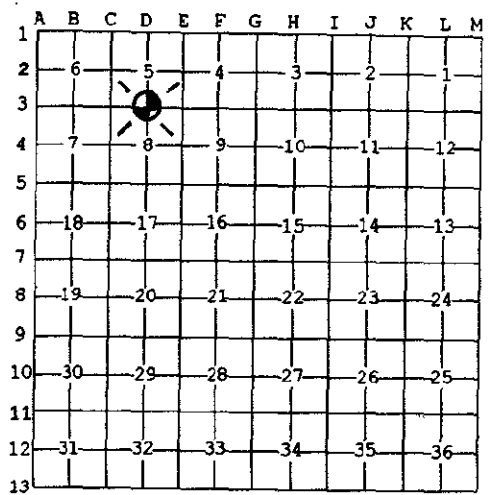

A. Description of original monument and accessories and/or subsequent restoration:

1829: United States Government Surveyors: Set 1/4 Section post.
Beech 20" East 17 lks.
Beech 14" S. 60° W. 17 lks.

1873: E. Strong, County Surveyor: "N. 1/4, Hick 8" N. 74 3/4° E., 68 lks and Ironwood 8"
S. 30° E., 76 lks., stone bi-section."

B. Description of corner evidence found and/or method applied in restoring or reestablishing corner:

1975: Gove Associates, D. Middleton # 16049; L.C.R.C., L/1, P/587, S 1/4 post (Section 5) stone, 4" down under pavement. Telephone pole South 46.5', Telephone pole has been sawed off, Power pole N. 05° W., 27.11', 26" Wild Cherry S. 50° W., 56.00'. S 1/4 post to SW corner measures 2648.9'.

1997: Found 8" x 8" x 14" stone below surface of road with P.K. nail over drill mark. S 1/4 post to SE corner measures 2645.6'.

RATIFIED
BY KALAMAZOO COUNTY
REMONUMENTATION
PEER GROUP

4-18-1997

C. Description of monument for corner and accessories established to perpetuate locating the position of the corner:

D-03: South 1/4 post, Section 5, T. 1 S., R. 12 W., ratified by the Kalamazoo County Remonumentation Program Peer Group on September 18, 1997 and is accepted as a careful and faithful perpetuation of the position of the original corner. Found stone as set by Ed Strong, County Surveyor in 1873 survey. Lowered stone and placed 6" Harrison monument in concrete with monument box over stone.

P.K. nail in West side	10" Double Wild Cherry	S. 30° E.	35.63
P.K. nail in West side	18" Wild Cherry	S. 56° W.	40.08
P.K. nail in East side(over nail/tab)	36" Maple	S. 72° W.	55.93
P.K. nail in East side	Power Pole	N. 08° W.	28.03

Signed by Robert E. Snell
Surveyor's Michigan License No. 9734

Date 12-16-97