

LAND CORNER RECORDATION CERTIFICATE
Filing Requirement of Act 74, Mich. P.A. 1970

For corners in Alamo Twp.

SURVEY & REMONUMENTATION

FEB 08 2000


SECTION

Register of Deeds Stamp & File Number

<u>Kalamazoo</u> (County)	Located in:	Corner Code #
1. Public Land Survey	T 1 S R 12 W	G-09
	T _____ R _____	_____
	T _____ R _____	_____
	T _____ R _____	_____
2. Property Controlling in Section	S _____ T _____ R _____	_____
	S _____ T _____ R _____	_____
3. Miscellaneous Property in Sec.	S _____ T _____ R _____	_____
	S _____ T _____ R _____	_____
4. Lot No. _____, Recorded Plat _____		
5. Private Claims		

I, Robert E. Snell, in a field survey on May 20, 1999 do hereby state that under requirements of P.A. 74, Michigan P.A. of 1970, the corner points mentioned in lines 1 and 2 above were in conformance with regulations and rules therefore as required in the current manual of survey instructions of the United States Department of the Interior, Bureau of Land Management or by a decree of a Court of Law and/or that the corner points mentioned in lines 3, 4 and 5 above were in conformance with the rules of the Michigan Board of Land Surveyors or by a Decree of a Court of Law; established, re-established, monumented, recovered, found as expressed below:

NOTE: Not more than 2 corners, all in the same town and range, may be recorded on this certificate.

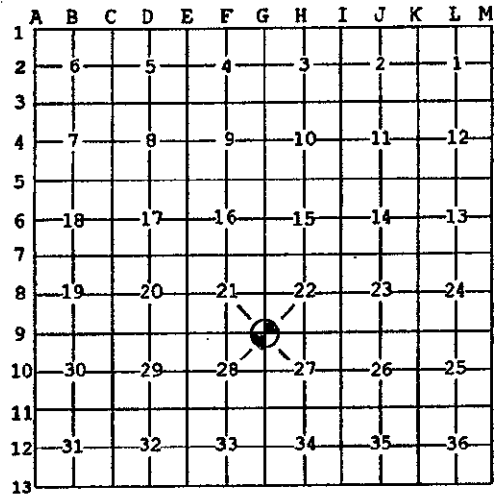

A. Description of original monument and accessories and/or subsequent restoration:

- 1829: United States Government Surveyor, R. Clark; set post, corner to Sections 21, 22, 27 and 28. Yellow Oak 18" S. 02° E. 105 lks. White Oak 15" N. 45° E. 115 lks.
- 1897: E. Strong, County Surveyor; found old stake. Set white stone. Sugar 3" S. 60° W. ± 48 lks., Cherry 2" N. 40° E. ± 72 lks.

B. Description of corner evidence found and/or method applied in restoring or reestablishing corner:

- 1931: Wilkins & Wheaton Engr. Co.; found drilled stone, 18" Elm S. 85° E. 26.1', fence on East side of road 30.0', fence on West side of road 24.7', SE corner House Northwest 94.95', fence line East 1.0' South.
- No Date: From Acro Engr. Section Witnesses; found drilled stone, set 3/4" pipe along North side dist. Service pole N. 50° W. 40.86', 14" Pine S. 62° W. 34.52', 40" Elm S. 80° E. 26.14', face/fence post S. 88° E. 27.85', Tel. Pole S. 43° W. 62.72' in line with fence East.
- 1975: D. Gilchrist, R.L.S. #13583; LCRC L-1, P-624, 1/2" pipe in monument box, P.P. East 75.09', P.P. N. 50° W. 40.69', 12" Pine S. 45° W. 35.56'
- 1999: Found 1/2" x 18" iron with cap in monument box. Dug a 3' x 3' x 3 1/2' hole and found no evidence of stone or pipe.

C. Description of monument for corner and accessories established to perpetuate locating the position of the corner:

- G-09: Southeast corner, Section 21, T. 1 S., R. 12 W., ratified by the Kalamazoo County Remonumentation Program Peer Group on July 15, 1999 and is accepted as the best available evidence of the position of the original position. Found 1/2" iron in monument Box from witnesses in "B" above. Placed 20" Harrison monument in monument box in place of 1/2" iron.
- | | | | |
|--------------------------------|--------------------------------|-----------|--------|
| Double Head Nail in West Side | Power Pole (Service) | N. 50° W. | 39.73' |
| PK Nail in Face | Fence Post | S. 88° E. | 28.00' |
| Southeast Corner | House Foundation (burned down) | N. 57° W. | 95.00' |
| Double Head Nail in South Side | 18" Pine | S. 50° W. | 33.47' |

Signed by Robert E. Snell
 Surveyor's Michigan License No. 9734

Date 7-30-99

RATIFIED
BY KALAMAZOO COUNTY
REMONUMENTATION
PEER GROUP
 7-15-1999