

APR 01 1996

COMMISSION LAND CORNER RECORDATION CERTIFICATE Filing Requirement of Act 74, Mich. P.A. 1970

STATE OF MICHIGAN COUNTY OF KALAMAZOO RECEIVED FOR RECORD '96 JAN 23 PM 3 50

For corners in Kalamazoo (County) Located In: Charleston Twp. Corner Code # B-4
1. Public Land Survey T 2 S. R 9 W.
2. Property Controlling in Section S T R
3. Miscellaneous Property in Section S T R


James J. Young COUNTY-REGISTER

LIBER 1 1436

Register of Deeds Stamp & File Number

4. Lot No. Recorded Plat
5. Private Claims

I, Robert E. Snell, in a field survey on July 15, 1994, do hereby certify that under requirements of P.A. 74, Michigan P.A. of 1970, the corner points mentioned in lines 1 and 2 above were in conformance with regulations and rules therefore as required in the current manual of survey instructions of the United States Department of the Interior, Bureau of Land Management or by a decree of a Court of Law and/or that the corner points mentioned in lines 3, 4 and 5 above were in conformance with the rules of the Michigan Board of Professional Surveyors or by a Decree of a Court of Law; established, re-established, monumented, re-monumented, recovered, found as expressed below:

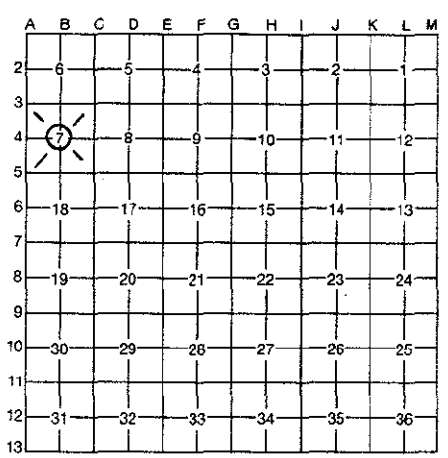

NOTE: Not more than 4 corners, all in the same town and range, may be recorded on this certificate.

A. Description of original monument and accessories and/or subsequent restoration:

- This corner not placed by original Government Surveyors.
1883: F. Hodgman, County Surveyor; divided 5-7 (N. 1/4 post and S. 1/4 post). Set 1/8 post.
1913: Glen Wheaton, Michigan Engineering Company; notes of Section 7 show iron at center of Section.
1928: Wilkins & Wheaton Engineering Co.; field notes show iron at center of Section. No ties or witnesses. This post has been used by this company thru the years.

B. Description of corner evidence found and/or method applied in restoring or reestablishing corner:

- 1994: Found 1/2" x 18" iron below paved surface. This iron is 10' West of iron and 33' North of iron placed in a survey by Wilkins & Wheaton Engineering Co. in 1961.

RATIFIED BY KALAMAZOO COUNTY REMONUMENTATION PEER GROUP 11-16-95

C. Description of monument for corner and accessories established to perpetuate locating the position of the corner:

B-4: Center of Section 7, T. 2 S., R. 9 W., Ratified by Kalamazoo County Remonumentation Program Peer Group on November 16, 1995. This position not established by original Government Surveyors. This monument is accepted as the best available evidence of the position of the corner. Found 1/2" x 18" iron below surface of road. Placed 20" Harrison Monument and Monument Box in the position of the corner.

Table with 4 columns: Monument Type, Size, Direction, Distance. Includes items like PK Nail in E. Side, 10" Twin Hickory, S. 12° E., 31.80'.

Signed by Robert E. Snell

Date 1-18-96

Surveyor's Michigan License No. 9734