

LAND CORNER RECORDATION CERTIFICATE
Filing Requirement of Act 74, Mich. P.A. 1970

For corners in

Kalamazoo

(County)

Charleston Section 8

Located In:

Corner Code ##

- | | | |
|------------------------------------|---------------------------|------------|
| 1. Public Land Survey | T <u>2</u> S R <u>9</u> W | <u>C-3</u> |
| | T _____ R _____ | _____ |
| | T _____ R _____ | _____ |
| | T _____ R _____ | _____ |
| 2. Property Controlling in Section | S _____ T _____ R _____ | _____ |
| | S _____ T _____ R _____ | _____ |
| 3. Miscellaneous Property in Sec. | S _____ T _____ R _____ | _____ |
| | S _____ T _____ R _____ | _____ |

4. Lot No. _____, Recorded Plat _____
5. Private Claims _____

CLERK - REGISTER
Jessie R. [Signature]

STATE OF MICHIGAN
 COUNTY OF KALAMAZOO
 RECEIVED FOR RECORD
 '94 MAR 15 PM 1 38

LIBER 1 PC 1115
 Register of Deeds Stamp & File Number

I, Robert E. Snell, in a field survey on January 12, 19 94, do hereby certify that under requirements of P.A. 74, Michigan P.A. of 1970, the corner points mentioned in lines 1 and 2 above were in conformance with regulations and rules therefore as required in the current manual of survey instructions of the United States Department of the Interior, Bureau of Land Management or by a decree of a Court of Law and/or that the corner points mentioned in lines 3, 4 and 5 above were in conformance with the rules of the Michigan Board of Land Surveyors or by a Decree of a Court of Law; established, re-established, monumented, re-monumented, recovered, found as expressed below:

NOTE: Not more than 4 corners, all in the same town and range, may be recorded on this certificate.

A. Description of original monument and accessories and/or subsequent restoration:

Original corner established by U.S. Government Survey-1826. Set Post.


- Wh. Oak 7" South 74°-E 9 Lks (5.94')
- Wh. Oak 36" North 49°-W 17 Lks (11.22')

1883-F. Hodgeman County Surveyor-ran North 74°-W, 9 Lks (5.94') from stump of U.S. bearing tree to stake hole. Other bearing tree lies overturned nearby. Bored three feet, put one-foot earthen post, one-foot stone, and one-foot earthen post with stone around.

- Cherry 12" N 29½° E 58 Lks (38.28')
- Hickory 6" S 80° W 43½ Lks (28.71')

B. Description of corner evidence found and/or method applied in restoring or reestablishing corner:

Found solid clay tile with "X" on top with three large stones around.

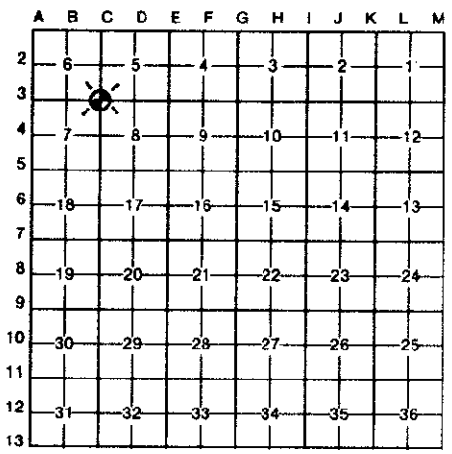

RATIFIED
BY KALAMAZOO COUNTY
REMONUMENTATION
PEER GROUP
 1-20-94

C. Description of monument for corner and accessories established to perpetuate locating the position of the corner:

C-3 Northwest corner Section 8, T. 2 S., R. 9 W., ratified by Kalamazoo Remonumentation Program Peer Group on January 20, 1994. Found solid clay tile with "X" on top as called for in 1883 remonumentation survey by F. Hodgeman and is accepted as a careful and faithful perpetuation of the position of the original corner. Placed remonumentation sleeve over tile.

- | | | | | | | |
|--------------------|-------------|---------|--------|-----------------|---------|--------|
| PK Nail in SE side | 12" Hickory | N 60° E | 11.74' | 30" Oak | N 85° E | 13.75' |
| PK Nail in S side | 17" Maple | S 30° W | 43.60' | Angle point | | |
| PK Nail in S side | 15" Hickory | West | 28.38' | in power line | South | 94.5' |
| PK Nail in SW side | 12" Oak | N 20° W | 30.43' | North and South | | |
| Centerline of | 40" Oak | North | 3.64' | fence | West | 1.9' |
| | | | | Fence to East | North | 1.7' |

Signed by Robert E. Snell

Date 3-15-94

Surveyor's Michigan License No. 9734