

1935

STATE OF MICHIGAN
COUNTY OF KALAMAZOO
RECEIVED FOR RECORD

'95 AUG 25 PM 3 51

LAND CORNER RECORDATION CERTIFICATE
Filing Requirement of Act 74, Mich. P.A. 1970

For corners in

Kalamazoo
(County)

Located In:

Corner Code #

Charleston Township

1. Public Land Survey

T 2 S R 9 W

D-7

T _____ R _____

T _____ R _____

T _____ R _____

2. Property Controlling
in Section

S _____ T _____ R _____

S _____ T _____ R _____

3. Miscellaneous
Property in Sec.

S _____ T _____ R _____

S _____ T _____ R _____

4. Lot No. _____, Recorded Plat _____

5. Private Claims _____


Jessie Jones
CLERK-REGISTER

LIBER 1 **1331**

Register of Deeds Stamp & File Number

I, Robert E. Snell, in a field survey on September 19, 19 94,

do hereby certify that under requirements of P.A. 74, Michigan P.A. of 1970, the corner points mentioned in lines 1 and 2 above were in conformance with regulations and rules therefore as required in the current manual of survey instructions of the United States Department of the Interior, Bureau of Land Management or by a decree of a Court of Law and/or that the corner points mentioned in lines 3, 4 and 5 above were in conformance with the rules of the Michigan Board of Land Surveyors or by a Decree of a Court of Law; established, re-established, monumented, re-monumented, recovered, found as expressed below:

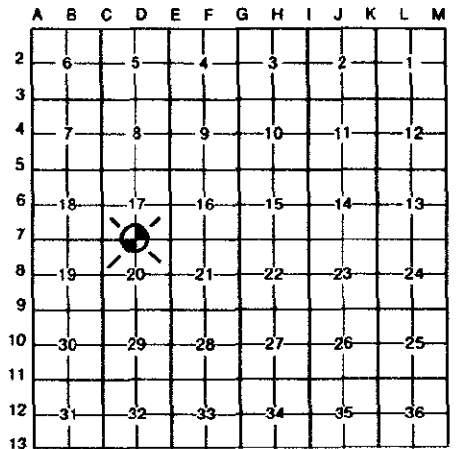

NOTE: Not more than 4 corners, all in the same town and range, may be recorded on this certificate.

A. Description of original monument and accessories and/or subsequent restoration:

1826: United States Government Surveyors; Set 1/4 Section Post.

Wh. Oak 10" North 12° West 35 Lks
Blk. Oak 12" South 79° West 30 Lks

1877: F. Hodgman, County Surveyor; Lost, bisected 3-4 (Southeast Corner and Southwest Corner Section 17). Set stake with stone over it.

Wh. Oak 12" North 37° West 182 Lks

1883: F. Hodgman, County Surveyor; Set 3' earthen post with stone around.

B. Description of corner evidence found and/or method applied in restoring or reestablishing corner:

1994: Found 3" round tile with "mushroom head".

RATIFIED
BY KALAMAZOO COUNTY
REMONUMENTATION
PEER GROUP
5-18-95

R.E.S.

C. Description of monument for corner and accessories established to perpetuate locating the position of the corner:

D-7 South 1/4 Post Section 17, T. 2 S., R. 9 W., Ratified by the Kalamazoo County Remonumentation Program Peer Group on May 18, 1995 and is accepted as a careful and faithful perpetuation of the position of the original corner. Found a 3" round tile in old fence line with stones around as called for by F. Hodgman in 1883 remonumentation survey. Removed "mushroom head" and placed remonumentation sleeve over tile.

PK Nail in North Side 12" Cedar South 80° East 3.27'
PK Nail in West Side 12" Triple Apple South 22° East 25.34'
PK Nail in South Side 14" Apple North 38° East 55.63'
PK Nail in East Side 18"-24" Triple Apple North 16° West 59.90'

Signed by *Robert E. Snell*

Date 8-22-95

Surveyor's Michigan License No. 9734