

SURVEY & REMONUMENTATION

AUG 06 1996

COMMISSION

For corners in Kalamazoo
(County)
Charleston Twp.

LAND CORNER RECORDATION CERTIFICATE
Filing Requirement of Act 74, Mich. P.A. 1970

Located In: _____ Corner Code # _____

1. Public Land Survey	T	<u>2</u> S.	R	<u>9</u> W.	<u>E-07</u>
	T	_____	R	_____	_____
	T	_____	R	_____	_____
	T	_____	R	_____	_____
2. Property Controlling in Section	S	_____	T	_____	R
	S	_____	T	_____	R
3. Miscellaneous Property in Section	S	_____	T	_____	R
	S	_____	T	_____	R


CLERK - REGISTER
[Signature]

STATE OF MICHIGAN
COUNTY OF KALAMAZOO
RECEIVED FOR RECORD
MAY 23 PM 1 46 '96

LIBER 1 PAGE 1490
Register of Deeds Stamp & File Number

4. Lot No. _____, Recorded Plat _____
5. Private Claims _____

RATIFIED
BY KALAMAZOO COUNTY
REMONUMENTATION
PEER GROUP
[Signature]
5-16-1996

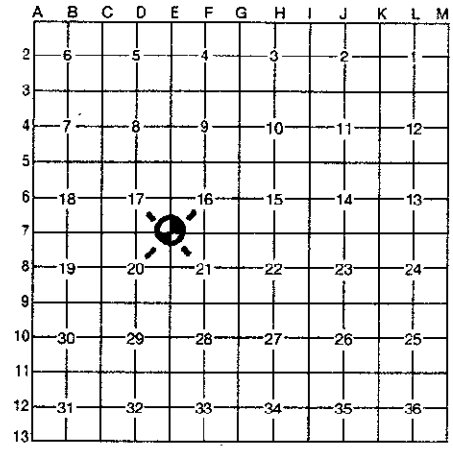

I, Robert E. Snell, in a field survey on April 23, 1996, do hereby certify that under requirements of P.A. 74, Michigan P.A. of 1970, the corner points mentioned in lines 1 and 2 above were in conformance with regulations and rules therefore as required in the current manual of survey instructions of the United States Department of the Interior, Bureau of Land Management or by a decree of a Court of Law and/or that the corner points mentioned in lines 3, 4 and 5 above were in conformance with the rules of the Michigan Board of Professional Surveyors or by a Decree of a Court of Law; established, re-established, monumented, re-monumented, recovered, found as expressed below:

NOTE: Not more than 4 corners, all in the same town and range, may be recorded on this certificate.

A. Description of original monument and accessories and/or subsequent restoration:

- 1826: United States Government Surveyors; set post common to Sections 16, 17, 20 & 21.
Blk. Oak 15" S. 48° W. 49 lks.
Blk. Oak 9" N. 30° E. 67 lks.
- 1883: F. Hodgman, County Surveyor; found stake in 1877 from 2 witness stumps and set stone. W.O. Oak N. 63° W. 69 lks., Butternut 6" S. 43½° E. 128½ lks. in 1883 found stone and replaced with 3' of earthen tile with stones around, 1877 witnesses are good.

B. Description of corner evidence found and/or method applied in restoring or reestablishing corner:

- 1950: Wilkins & Wheaton Engr. Co.; found ½" x 18" long iron bar over tile.
Blk. Walnut N. 20° E. 53.2'
Elm 30" S. 25° E. 69.0'
Y. Oak N. 80° W. 32.6'
- 1990: Ronnie M. Lester, RLS #18998; L.C.R.C. L-1, P-925, found 5/8" iron in monument box.
Nail and Tag on East Side 36" Cherry 218° Az. 45.9'
Nail and Tag on South Side 40" Oak 283° Az. 33.2'
Nail and Tag on West Side 12" Cherry 145° Az. 51.6'
- 1996: Found 5/8" x 24" long iron bar over tile 28" deep in monument box. Second monument box N. 45° W. 3.5'±.

C. Description of monument for corner and accessories established to perpetuate locating the position of the corner:

- E-07: Northwest corner of Section 21, T. 2 S., R. 9 W., Ratified by the Kalamazoo County Remonumentation Program Peer Group on May 16, 1996, and is accepted as a careful and faithful perpetuation of the position of the original corner. Found 3" round tile as set by F. Hodgman, County Surveyor in an 1883 remonumentation survey. Placed 20" Harrison Monument over tile in monument box.
PK Nail on North Side of 12" Twin Elm S. 80° E. 28.92'
Nail and Tab on West Side of 14" Wild Cherry S. 30° E. 51.54'
Nail and Tab on East Side 28" Butternut S. 30° W. 45.89'
Nail and Tab on South Side of 32" Oak N. 80° W. 33.25'

Signed by *Robert E. Snell*
Surveyor's Michigan License No. 9734

Date 5-23-96