

SURVEY & REMONUMENTATION

APR 27 1995

COMMISSION

LAND CORNER RECORDATION CERTIFICATE

Filing Requirement of Act 74, Mich. P.A. 1970 '94 DEC 6 PM 3 56

STATE OF MICHIGAN
COUNTY OF KALAMAZOO
RECEIVED FOR RECORD

For corners in

Kalamazoo

(County)

Charleston

Located In:

Corner Code #

- | | | | | | | | |
|------------------------------------|---|---|---|---|---|---|------|
| 1. Public Land Survey | T | 2 | S | R | 9 | W | K-12 |
| | T | | | R | | | |
| | T | | | R | | | |
| | T | | | R | | | |
| 2. Property Controlling in Section | S | | T | | R | | |
| | S | | T | | R | | |
| 3. Miscellaneous Property in Sec. | S | | T | | R | | |
| | S | | T | | R | | |
4. Lot No. _____, Recorded Plat _____
5. Private Claims _____

James J. Jupp

CLERK-REGISTER

LIBER

1 PG 1190

Register of Deeds Stamp & File Number

I, Robert E. Snell, in a field survey on September 23, 19 94

do hereby certify that under requirements of P.A. 74, Michigan P.A. of 1970, the corner points mentioned in lines 1 and 2 above were in conformance with regulations and rules therefore as required in the current manual of survey instructions of the United States Department of the Interior, Bureau of Land Management or by a decree of a Court of Law and/or that the corner points mentioned in lines 3, 4 and 5 above were in conformance with the rules of the Michigan Board of Land Surveyors or by a Decree of a Court of Law; established, re-established, monumented, re-monumented, recovered, found as expressed below:

NOTE: Not more than 4 corners, all in the same town and range, may be recorded on this certificate.

A. Description of original monument and accessories and/or subsequent restoration:

1826: U.S. Government Survey; Set 1/4 Section Post.

Bl. Oak	16"	South	29°	West	31 Lks
Y. Oak	12"	South	39°	East	57 Lks

1883: F. Hodgeman, County Surveyor; Found nothing, Corner Post plowed out in road and witness trees gone. Bisected the East line of the Section. Bored 3', filled bottom with broken brick and put a 2' earthen post over. Noted

Maple 6"	North	53½°	West	69 Lks
Maple 4"	South	65°	West	121 Lks


B. Description of corner evidence found and/or method applied in restoring or reestablishing corner:

1994: Found tile in monument box down about 6". One witness standing, one witness stump remaining from 1972 LCRC, Liber 1, Page 211 by John Kester.

C. Description of monument for corner and accessories established to perpetuate locating the position of the corner:

K-12 East 1/4 Post Section 35, T. 2 S., R. 9 W., Ratified by the Kalamazoo County Remonumentation Program Peer Group on November 17, 1994. Found 3" round tile as called for in 1883 remonumentation survey by F. Hodgeman and is a careful and faithful perpetuation of the original corner's position. Placed remonumentation sleeve over tile and placed 6" monument box extension over to bring to the surface.

PK Nail	in West Side	7" Maple	North 50° East	46.29'
PK Nail	in North Side	6" Maple	South 50° East	61.20'
Exist. Nail/Tab	in East Side	7" Maple	South 10° East	29.06'
PK Nail	in South Side	36" Maple	North 68° West	75.40'

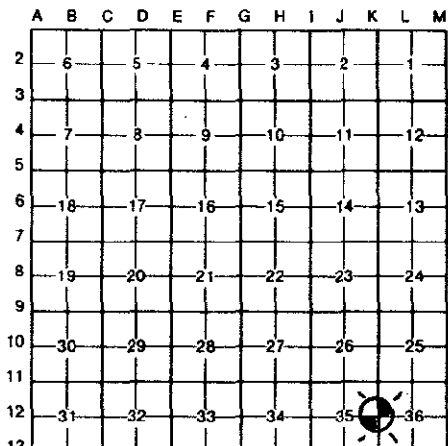

**RATIFIED
BY KALAMAZOO COUNTY
REMONUMENTATION
PEER GROUP**
 11/17/94 *R. E. Snell*

Signed by

Robert E. Snell

Date

12-5-94

Surveyor's Michigan License No.

9734