

LAND CORNER RECORDATION CERTIFICATE  
Filing Requirement of Act 74, Mich. P.A. 1970

STATE OF MICHIGAN  
COUNTY OF KALAMAZOO  
RECEIVED FOR RECORD  
98 DEC 23 AM 3 05  
CLERK - REGISTER

For corners in

Kalamazoo Located In: \_\_\_\_\_ Corner Code# \_\_\_\_\_  
(County)  
Comstock Twp.

1. Public Land Survey	T 2S	R 10W	C3
	T _____	R _____	_____
	T _____	R _____	_____
	T _____	R _____	_____
2. Property Controlling in Section	S _____	T _____	R _____
	S _____	T _____	R _____
3. Miscellaneous Property in Sec.	S _____	T _____	R _____
	S _____	T _____	R _____

Register of Deeds Stamp & File Number

4. Lot No. \_\_\_\_\_, Recorded Plat \_\_\_\_\_  
5. Private Claims \_\_\_\_\_

I, Gary D. Hahn, in a field survey on February 3, 1998 do hereby state that under requirements of P.A. 74, Michigan P.A. of 1970, the corner points mentioned in lines 1 and 2 above were in conformance with regulations and rules therefore as required in the current manual of survey instructions of the United States Department of the Interior, Bureau of Land Management or by a decree of a Court of Law and /or that the corner points mentioned in lines 3, 4 and 5 above were in conformance with the rules of the Michigan Board of Land Surveyors or by a Decree of a Court of Law; established, re-established, monumented, recovered, found as expressed below:

NOTE: Not more than 2 corners, all in the same town and range, may be recorded on this certificate.

A	B	C	D	E	F	G	H	I	J	K	L	M
1												
2	6		5		4		3		2		1	
3		●										
4	7		8		9		10		11		12	
5												
6	18		17		16		15		14		13	
7												
8	19		20		21		22		23		24	
9												
10	30		29		28		27		26		25	
11												
12	31		32		33		34		35		36	
13												

A. Description of original monument and accessories and/or subsequent restoration:

1827 - Corner established by Deputy Surveyor Robert Clark, Jr.  
Set post cor. Sec. 5,6,7, + 8 Wh. Oak 14 in N 12½ W 71 lks. Wh. Oak 12 in S 57 W 71 lks.  
V6. P. 416 Hodgmen: "Stone, cylinder + earthen + 5 stone 10 stake"  
1864 F. Stimpson - "Found stake hole by Gov. Survey and planted stone and cylinders and broken earth"  
1885 F. Hodgmen " Found old stake w/cylinder around said by R. Jickling to have been kept in place of original stake. Set post w/ stone around"

B. Description of corner evidence found and/or method applied in restoring or reestablishing corner:

Original monument and accessories not recovered. Found Pk nail in asphalt. Did not excavate due to existence of sanitary sewer.

C. Description of monument for corner and accessories established to perpetuate locating the position of the corner:


C3, Northeast Corner Section 7, Town 2 South, Range 10 West, ratified by Kalamazoo County Remonumentation Peer Group on March 19, 1998. Location of PK nail is accepted as the best available evidence of the position of the original corner. Removed PK nail and set a 20" Harrison monument in a monument box.

Witness ties:

- Found PK nail w/tab in P.P. N 35 degrees West 51.78 feet.
- Found PK nail w/tab in P.P. N 55 degrees East 49.00 feet.
- Found Pk Nail w/tab in 36 inch triple maple South 35.40 feet.
- Found steel fence post filled with concrete S 15 degrees W 29.37 feet.

RATIFIED  
BY KALAMAZOO COUNTY  
REMONUMENTATION  
PEER GROUP

3/19/98  
R.D.S.

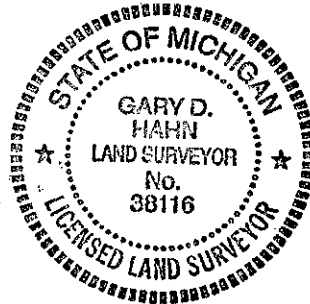

Signed by [Signature]  
Surveyor's Michigan License No. 38116

Date 12/08/98

FORM APPROVED BY MICHIGAN STATE BOARD OF PROFESSIONAL SURVEYORS,  
JAN. 28, 1971  
REVISED MAY 14, 1975  
REVISED JAN., 1983 REVISED OCT., 1996

SURVEY &  
REMONUMENTATION

FEB 08 1999

SECTION