LIBER 2 PAGE 418

STATE OF MICHIGAN
COUNTY OF KALAMAZOO
RECEIVED FOR RECORD
'98 DEC 23 AM 3 05
CLERK - REGISTER

Register of Deeds Stamp & File Number

LAND CORNER RECORDATION CERTIFICATE
Filing Requirement of Act 74, Mich. P.A. 1970

For corners in

Kalamazoo (County) Located In: Comstock Township Corner Code# C-11

1. Public Land Survey		T 2S	R 10W	C-11
		T	R	
		T	R	
		T	R	
2. Property Controlling	S	T	R	
in Section	S	T	R	
3. Miscellaneous	S	T	R	
Property in Sec.	S	T	R	

4. Lot No. _____ , Recorded Plat _____
5. *Private Claims* _____

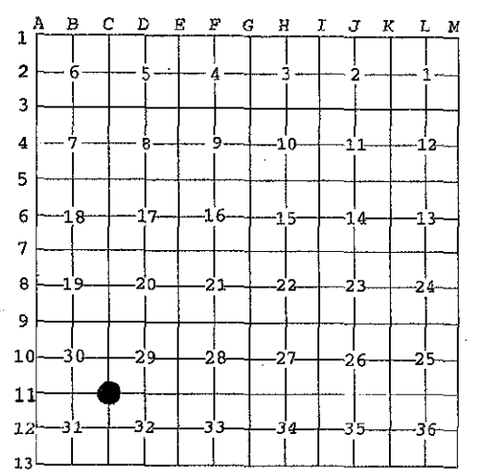

I, Gary D. Hahn, in a field survey on November 5, 19 98 do hereby state that under requirements of P.A. 74, Michigan P.A. of 1970, the corner points mentioned in lines 1 and 2 above were in conformance with regulations and rules therefore as required in the current manual of survey instructions of the United States Department of the Interior, Bureau of Land Management or by a decree of a Court of Law and /or that the corner points mentioned in lines 3, 4 and 5 above were in conformance with the rules of the Michigan Board of Land Surveyors or by a Decree of a Court of Law; established, re-established, monumented, recovered, found as expressed below:

NOTE: Not more than 2 corners, all in the same town and range, may be recorded on this certificate.

A. Description of original monument and accessories and/or subsequent restoration:

1827 - Established by U.S. Deputy Surveyor Robert Clark, Jr.
Sugar 18" S 11 W 25 lks. Beech 8" S 72 E 19 lks.

1885 - F. Hodgman - "Found old corner stake, iron and brick. Wild Cherry 3" S 62½" E 54 lks. Elm 6" N 79 E 51 lks." Gives distance of 39.78 ch = 2625.48' N.W. Cor. to W. 1/4 Post.

1885 - F. Hodgman - "Found post and B. Tree of resurvey correct. Set post with brick and iron under".

KCRC Witness Notes - Iron (Watson 11-17-72)
36" Elm N 79 E 33.00'
36" Cherry N 40 W 49.4'
30" Cherry N 30 W 62.52'

RATIFIED
BY KALAMAZOO COUNTY
REMONUMENTATION
PEER GROUP
12/17/98

B. Description of corner evidence found and/or method applied in restoring or reestablishing corner:

1998 - Found 3/4" dia. x 24" long rod in mon. box. Found two sections of tile (top section leaning). Found ½" x 2 1/4" iron with "nub" along east side of tile. Top of bottom section of tile is 26" below road surface. Tile is 0.15' north and 2.32' west of rod.

C. Description of monument for corner and accessories established to perpetuate locating the position of the corner:

C-11, Northwest Corner Section 32, Town 2 South, Range 10 West, ratified by Kalamazoo County Remonumentation Peer Group on December 17, 1998. Position of the tile is accepted as a careful and faithful perpetuation of the position of the original corner. Set 20" Harrison Monument in a Monument Box direclty over tile.

Witness Ties:
Set Mag. Nail in P.P. N 85 E 31.00'
Set Mag. Nail in 4" Maple N 57 E 34.78'
Top bolt on hydrant N 47 W 47.47'
Top of metal fence post S 45 E 41.61'

STATE OF MICHIGAN
GARY D. HAHN
LAND SURVEYOR
No. 38116
LICENSED LAND SURVEYOR

Signed by _____ Date 12/21/98
Surveyor's Michigan License No. 38116

FORM APPROVED BY MICHIGAN STATE BOARD OF PROFESSIONAL SURVEYORS, JAN.28,1971
REVISED MAY 14,1975
REVISED JAN., 1983 REVISED OCT., 1996

SURVEY & REMONUMENTATION
FEB 08 1999
SECTION