

FEB 08 2000




LC-000010 Page: 1 of 1 07/30/1999 08:24A BK-2 Pg-463

SECTION

LAND CORNER RECORDATION CERTIFICATE Filing Requirement of Act 74, Mich. P.A. 1970


For corners in Comstock Twp.

Form with fields for Kalamazoo (County), Located in: (Town/Range/Section), Corner Code #, and numbered items 1-5 for survey details.

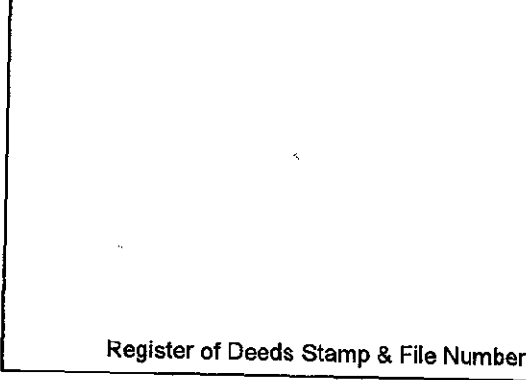

I, Robert E. Snell, in a field survey on June 8, 1999 do hereby state that under requirements of P.A. 74, Michigan P.A. of 1970, the corner points mentioned in lines 1 and 2 above were in conformance with regulations and rules therefore as required in the current manual of survey instructions of the United States Department of the Interior, Bureau of Land Management or by a decree of a Court of Law and/or that the corner points mentioned in lines 3, 4 and 5 above were in conformance with the rules of the Michigan Board of Land Surveyors or by a Decree of a Court of Law; established, re-established, monumented, recovered, found as expressed below:

NOTE: Not more than 2 corners, all in the same town and range, may be recorded on this certificate.

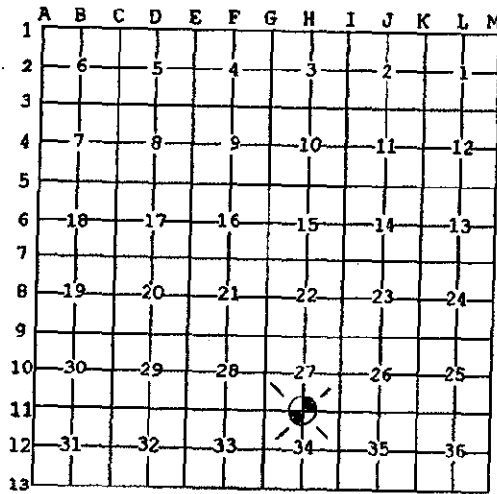

A. Description of original monument and accessories and/or subsequent restoration:

- 1827: United States Government Surveyors, R. Clark; set 1/4 Section post. Beech 13" S. 51° E. 20 lks. Beech 18" S. 81° W. 30 lks.
1885: F. Hodgman, County Surveyor; "Found iron stake with stone and brick around, in line with fences East & West. Set post with iron under and stone around." Maple 4" East 40 1/2 lks. (26.73') Black Walnut 10" N. 30° E. ± 108 1/2 lks. Not marked.

B. Description of corner evidence found and/or method applied in restoring or reestablishing corner:

- 1959: Acro Engineering, source of witnesses unknown; 15" Maple East 26' 15" Maple Southeast 26' SW cor. porch NE 48.3'
1999: Found 3" round tile 13" below surface of road with stone and brick over. Noted 1/2" x 18" iron 1.45' South and 3.5' West, also 38" Maple East 25'.

RATIFIED BY KALAMAZOO COUNTY REMONUMENTATION PEER GROUP 7-15-99

C. Description of monument for corner and accessories established to perpetuate locating the position of the corner:

H-11: South 1/4 post, Section 27, T. 2 S., R. 10 W., ratified by the Kalamazoo County Remonumentation Program Peer Group on July 15, 1999, and is accepted as a careful and faithful perpetuation of the position of the original corner. Found 3" round tile with "X" on top 13" below surface of road with brick and stone over it. Tile was set by F. Hodgman in 1885 Remonumentation survey. Placed remonumentation sleeve on tile with 10" Harrison monument in monument box over.

Table listing monument details for Southwest corner: Concrete Block Foundation (Hse. #3213), Power Pole (old), 34" Maple, Power Pole (new) with bearings and distances.

Signed by [Signature] Surveyor's Michigan License No. 9734

Date 7-28-99