3. Miscellaneous

Property in Section

COMMUNICATION LAND CORNER RECORDATION CERTIFICATE

Filina	Requirement	of A	ct 74.	Mich.	P.A.	1970

5	Finity Requirement of Act 74, Wich. F.A. 1970		
For corners in Kalamazoo (County) Kalamazoo Twp.	Located In:	Corner Code #	7
Public Land Survey	T <u>2 S.</u> R <u>11 W</u> . T R T R	B-13	Ţ
Property Controlling in Section	S T R		LIBER 1


PAGE 1495

Register of Deeds Stamp & File Number

4.	Lot No,	Recorded Plat
5	Private Claims	

I. Robert E. Snell, in a field survey on February 16 do hereby certify that under requirements of P.A. 74, Michigan P.A. of 1970, the corner points mentioned in lines 1 and 2 above were in conformance with regulations and rules therefore as required in the current manual of survey instructions of the United States Department of the Interior, Bureau of Land Management or by a decree of a Court of Law and/or that the corner points mentioned in lines 3, 4 and 5 above were in conformance with the rules of the Michigan Board of Professional Surveyors or by a Decree of a Court of Law; established, re-established, monumented, re-monumented, recovered, found

NOTE: Not more than 4 corners, all in the same town and range, may be recorded



1825: United States Government Surveyors; set 1/4 Section post.

W. Oak 7" East 13 lks. N. 39½0 W. W. Oak 8" 19 1ks.

F. Hodgman, County Surveyor; found stake hole 13 lks. West of W. Oak bearing tree of 1885:

U.S. Survey. Set post.

S. 51½0 W. Wh. Oak 12" (No distance recorded)

RATIFIED BY KALAMAZOO COUNTY REMONUMENTATION PEER GROUP

B. Description of comer evidence found and/or method applied in restoring or reestablishing corner:

1927: Wilkins & Wheaton Engineering Co.; found tile.

Michigan State Highway Department Surveyors; found brass cap marked "State of Michigan".

> S. 05⁰ E. S. 55⁰ W. 6" Iron Pipe (fence corner) 8" Hickory 10" Twin Cherry

Found 4" dia. brass cap in slightly larger sleeve 3" below surface from above 1996: witnesses. Dug along side of sleeve and found two pieces of clay tile laying along sides of sleeve. Said sleeve being 3½'+ into ground.

C. Description of monument for corner and accessories established to perpetuate locating the position of the corner.

South 1/4 post Section 31, T. 2 S., R. 11 W., Ratified by the Kalamazoo County Remonumentation Program Peer Group on May 2, 1996 and is accepted as a careful and faithful perpetuation of the position of the original corner. Found 4" brass cap in sleeve and is retained as the monument.

PK Nail in West Side	20" W. Cherry	N. 22 ⁰ E. N. 78 ⁰ E.	18.63
Existing Nail/Tab in North Side	Twin 18" W. Cherry	N. 78 ⁰ E.	15.75
PK Nail in West Side	10" Tree of Heaven	\$. 50° E.	28.421
PK Nail in North Side	10" Hickory	S. 56 ⁰ W.	17,22'

Surveyor's Michigan License No.

9734