SURVEY & REMONUMENTATION COMMISSION
MAY 16 1996

LIBER 1 1459
'96 MAR 25 PM 3 30
STATE OF MICHIGAN COUNTY OF KALAMAZOO RECEIVED FOR RECORD
COUNTY REGISTER

LAND CORNER RECORDATION CERTIFICATE

Filing Requirement of Act 74, Mich. P.A. 1970

For corners in Kalamazoo (County)

Located In: Kalamazoo Twp.

Corner Code #

1. Public Land Survey		T 2 S. R 11 W.	D-13
		T ____ R ____	
		T ____ R ____	
		T ____ R ____	
2. Property Controlling	S ____	T ____ R ____	
in Section	S ____	T ____ R ____	
3. Miscellaneous	S ____	T ____ R ____	
Property in Section	S ____	T ____ R ____	

Register of Deeds Stamp & File Number

4. Lot No. _____, Recorded Plat _____
5. Private Claims _____

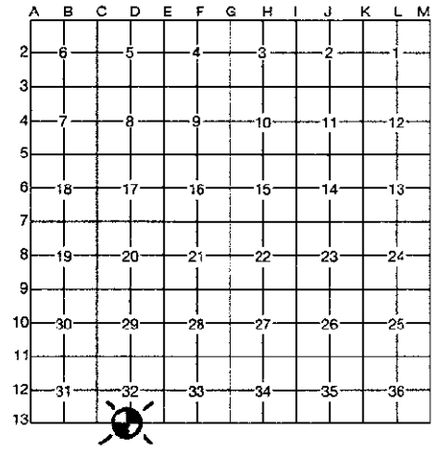

I, Robert E. Snell, in a field survey on February 15, 19 96, do hereby certify that under requirements of P.A. 74, Michigan P.A. of 1970, the corner points mentioned in lines 1 and 2 above were in conformance with regulations and rules therefore as required in the current manual of survey instructions of the United States Department of the Interior, Bureau of Land Management or by a decree of a Court of Law and/or that the corner points mentioned in lines 3, 4 and 5 above were in conformance with the rules of the Michigan Board of Professional Surveyors or by a Decree of a Court of Law; established, re-established, monumented, re-monumented, recovered, found as expressed below:

NOTE: Not more than 4 corners, all in the same town and range, may be recorded on this certificate.

A. Description of original monument and accessories and/or subsequent restoration:

1825: United States Government Surveyors; set 1/4 Section corner.

W. Oak 14"	N. 73° E.	13 lks.
Y. Oak 5"	N. 48¼° W.	13 lks.

1885: F. Hodgman, County Surveyor; ran S. 73° W. 13 lks. from stump of Wh. Oak and found stake hole. Also found where stump had been removed N. 48° W. 13 lks. from stake hole, set post with brick under.

Wh. Oak 12"	S. 23° E.	46 lks.
Wh. Oak 4"	N. 82° E.	74 lks.

B. Description of corner evidence found and/or method applied in restoring or reestablishing corner:

1954: R. Hansen, Surveyor; in recorded Plat (L-20, P-32) Hill-N-Brook Village #3, shows tile.

1996: Found 3" round tile with "x" on top 6" below surface.

RATIFIED BY KALAMAZOO COUNTY REMONUMENTATION PEER GROUP
3-21-96

C. Description of monument for corner and accessories established to perpetuate locating the position of the corner:

D-13: South 1/4 post Section 32, T. 2 S., R. 11 W., Ratified by the Kalamazoo County Remonumentation Program Peer Group on March 21, 1996 and is accepted as a careful and faithful perpetuation of the position of the original corner. Found 3" round tile with "x" on top as set by F. Hodgman in a Remonumentation survey in 1885. Placed Remonumentation sleeve over tile.

Exist. Nail/Tab in South Side	7" Juniper	S. 82° E.	3.92'	
1/2" Iron in Concrete	Plat Monument	S. 80° E.	14.34'	
Exist. Nail in East Side	10" W. Cherry	S. 48° E.	42.05'	
PK Nail in East Side	30" Oak	S. 30° E.	32.65'	Note: MSHD Nail/Tab
PK Nail in South Side	6" Cedar	S. 60° W.	6.98'	in West Side.

Signed by Robert E. Snell Date 3-25-96

Surveyor's Michigan License No. 9734

FORM APPROVED BY MICHIGAN STATE BOARD OF PROFESSIONAL SURVEYORS, JAN. 28, 1971
REVISED MAY 14, 1975
REVISED JAN., 1983