

FEB 08 1999

SECTION

LIBER 2 PAGE 372

LAND CORNER RECORDATION CERTIFICATE  
Filing Requirement of Act 74, Mich. P.A. 1970

For corners in Kalamazoo Twp.

| Kalamazoo<br>(County)                 | Located In: | Corner Code # |
|---------------------------------------|-------------|---------------|
| 1. Public Land Survey                 | T 2S R 11W  | G-11          |
|                                       | T R         |               |
|                                       | T R         |               |
|                                       | T R         |               |
| 2. Property Controlling<br>in Section | S T R       |               |
|                                       | S T R       |               |
| 3. Miscellaneous<br>Property in Sec.  | S T R       |               |
|                                       | S T R       |               |


STATE OF MICHIGAN  
COUNTY OF KALAMAZOO  
RECEIVED FOR RECORD  
98 NOV 23 PM 2 57  
Clerk - Register

Register of Deeds Stamp & File Number

4. Lot No. \_\_\_\_\_, Recorded Plat \_\_\_\_\_  
5. Private Claims \_\_\_\_\_

I, Robert E. Snell, in a field survey on Aug. 3, 19 98 do hereby state that under requirements of P.A. 74, Michigan P.A. of 1970, the corner points mentioned in lines 1 and 2 above were in conformance with regulations and rules therefore as required in the current manual of survey instructions of the United States Department of the Interior, Bureau of Land Management or by a decree of a Court of Law and for that the corner points mentioned in lines 3, 4 and 5 above were in conformance with the rules of the Michigan Board of Land Surveyors or by a Decree of a Court of Law; established, re-established, monumented, recovered, found as expressed below:

NOTE: Not more than 2 corners, all in the same town and range, may be recorded on this certificate.

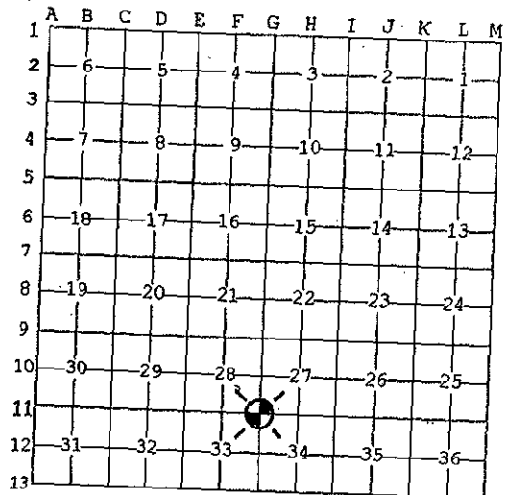

A. Description of original monument and accessories and/or subsequent restoration:

- 1827: United States Government Surveyors; set post, corner to Sections 27, 28, 33 & 34.  
Burr Oak 6" N. 24 1/2° W. 92 lks.  
Burr Oak 12" S. 55° E. 6 lks.
- 1885: F. Hodgman, County Surveyor; "found post N. 52 3/4° E. 21 lks. from stump of bearing tree by Stimpson. Set 3 ft. earthen post and marked  
Burr Oak 20" N. 23° W. 91 lks.  
Burr Oak 20" N. 33 1/2° E. 83 lks.

B. Description of corner evidence found and/or method applied in restoring or reestablishing corner:

- 1949: Wilkins & Wheaton Engr. Co.; placed notch in concrete pavement, concrete monument West on Section line 33.00' RR Spike East 33.0' on (North line of Section 33).
- 1998: During reconstruction of S. Westnedge Avenue found 1/2" iron in concrete, returned later to find 3" round tile 1'-1 1/2' below surface of street. 3 tiles stacked with top tile slightly shifted. Surface iron (in concrete) 0.26' West and 0.04' South of column of tiles.

RATIFIED  
BY KALAMAZOO COUNTY  
REMONUMENTATION  
PEER GROUP 8-20-1998

C. Description of monument for corner and accessories established to perpetuate locating the position of the corner:

G-11: Southwest corner, Section 27, T. 2 S., R. 11 W. ratified by the Kalamazoo County Remonumentation Program Peer Group on August 20, 1998 and is accepted as a careful and faithful perpetuation of the position of the original corner. Found three 3" round tiles in a column. Tiles set in 1885 Remonumentation survey by F. Hodgman, County Surveyor. Placed 20" Harrison monument over tiles in monument box after base courses of pavement were in place.

|                        |                          |           |        |
|------------------------|--------------------------|-----------|--------|
| 1/2" Iron with Red Cap | at back of curb at drive | N. 52° W. | 30.43' |
| 1/2" Iron with Red Cap | at back of curb at drive | S. 74° W. | 27.13' |
| 1/2" Iron with Red Cap | at back of curb at drive | S. 30° W. | 56.53' |
| PK Nail in North Side  | Power Pole               | S. 52° E. | 53.09' |

Signed by Robert E. Snell  
Surveyor's Michigan License No. 9734

Date 11-20-98