

APR 01 1996

COMMISSION

STATE OF MICHIGAN
COUNTY OF KALAMAZOO
RECEIVED FOR RECORD

'96 JAN 23 PM 3 50

LAND CORNER RECORDATION CERTIFICATE
Filing Requirement of Act 74, Mich. P.A. 1970

For corners in Kalamazoo Located in: _____ Corner Code # _____
 (County)
Kalamazoo Twp.


1. Public Land Survey	T <u>2</u> S. R <u>11</u> W.	<u>I-01</u>
	T _____ R _____	_____
	T _____ R _____	_____
	T _____ R _____	_____
2. Property Controlling in Section	S _____ T _____ R _____	_____
	S _____ T _____ R _____	_____
3. Miscellaneous Property in Section	S _____ T _____ R _____	_____
	S _____ T _____ R _____	_____

James J. Spring
CLERK-REGISTER

LIBER 1 1429

Register of Deeds Stamp & File Number

4. Lot No. _____, Recorded Plat _____
 5. Private Claims _____

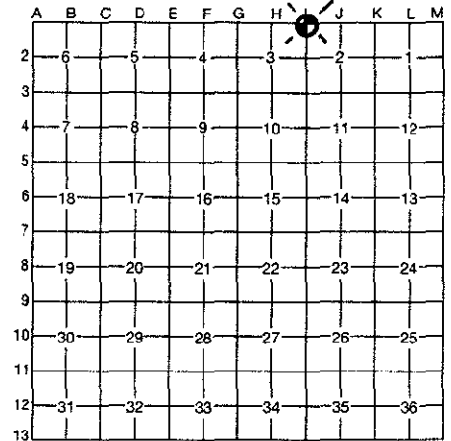

I, Robert E. Snell, in a field survey on October 25, 1995, do hereby certify that under requirements of P.A. 74, Michigan P.A. of 1970, the corner points mentioned in lines 1 and 2 above were in conformance with regulations and rules therefore as required in the current manual of survey instructions of the United States Department of the Interior, Bureau of Land Management or by a decree of a Court of Law and/or that the corner points mentioned in lines 3, 4 and 5 above were in conformance with the rules of the Michigan Board of Professional Surveyors or by a Decree of a Court of Law; established, re-established, monumented, re-monumented, recovered, found as expressed below:

NOTE: Not more than 4 corners, all in the same town and range, may be recorded on this certificate.

A. Description of original monument and accessories and/or subsequent restoration:

- 1827: United States Government Surveyors; intersected North boundary 14 lks. East of post. Set post at intersection of corner to Sections 2 and 3.
 Br. Oak 18" S 50 1/2° E. 18 lks.
 W. Oak 18" S. 75° W. 257 lks.
- 1884: F. Hodgman, County Surveyor; found old stake 14 lks. East of Cooper corner stone. Set post with stone and "T" rail under and stone around.
 Burr Oak 3" S. 09 3/4° E. 34 lks.
 Wh. Oak 2" N. 66 3/4° E. 80 lks.

B. Description of corner evidence found and/or method applied in restoring or reestablishing corner:

- 1938: Wilkins & Wheaton Engineering Co., found tile.
 Br. Oak S. 10° E. 21.9'
 Elm 18" N. 70° W. 69.9'
 Maple 24" N. 35° W. 66.3'
- 1995: Found tile in stone 12" below surface of road.

RATIFIED
BY KALAMAZOO COUNTY
REMONUMENTATION
PEER GROUP
 12-14-95 *R.E.S.*

C. Description of monument for corner and accessories established to perpetuate locating the position of the corner:

- I-01: Northwest corner Section 2, T. 2 S., R. 11 W., Ratified by Kalamazoo County Remonumentation Program Peer Group on December 14, 1995 and is accepted as a careful and faithful perpetuation of the position of the original corner. Found 3" round tile with "x" as called for in 1884 remonumentation survey by F. Hodgman, County Surveyor. Placed 10" of 20" Harrison Monument and Monument Box over tile.
- | | | | |
|--|------------|-----------|--------|
| PK Nail in E. Side | Guy Pole | S. 14° E. | 23.76' |
| PK Nail in N. Side | 30" Oak | N. 72° E. | 94.53' |
| PK Nail in E. Side | Power Pole | N. 32° E. | 28.34' |
| Double Head Nail in W. Side | 19" Elm | S. 35° W. | 39.66' |
| Double Head Nail in N. Side | 10" Ash | N. 64° W. | 86.64' |
| Iron (Southeast corner Section 34, Cooper) | West | 9.24' | |

Signed by *Robert E. Snell* Date 1-18-96

Surveyor's Michigan License No. 9734